

se 2-21-1

26825

WATER WELL RECORD


Form WWC-5

Division of Water Resources App. No.

1 LOCATION OF WATER WELL: County: STANTON Fraction 1/4 SW 1/4 SW 1/4 SE 1/4 Section Number 2 Township No. T 29 S Range Number R 39 [] E [x] W

Street/Rural Address of Well Location; if unknown, distance & direction from nearest town or intersection: FROM BIG BOW - 1 MILE SOUTH & 1/2 MILE EAST Global Positioning System (GPS) information: Latitude: Longitude: Elevation: Datum: Collection Method: GPS unit (Make/Model): Digital Map/Photo, Topographic Map, Land Survey Est. Accuracy: <3 m, 3-5 m, 5-15 m, >15 m

2 WATER WELL OWNER: DOUGLAS F BELL RR#, Street Address, Box #: 1 FORD DRIVE City, State, ZIP Code : COLBY KS 67701

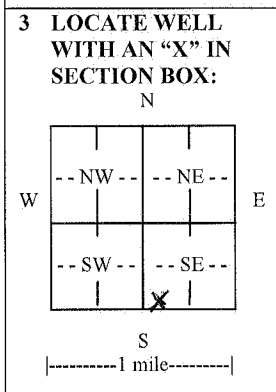

3 LOCATE WELL WITH AN 'X' IN SECTION BOX: 4 DEPTH OF COMPLETED WELL 379 ft. Depth(s) Groundwater Encountered (1) 379 ft. (2) ft. (3) ft. WELL'S STATIC WATER LEVEL 332 ft. below land surface measured on mo/day/yr Pump test data: Well water was ft. after hours pumping gpm EST. YIELD gpm. Well water was ft. after hours pumping gpm Bore Hole Diameter in. to ft., and in. to ft. WELL WATER TO BE USED AS: [] Public water supply [] Geothermal [] Injection well [] Domestic [] Feedlot [] Oil field water supply [] Dewatering [] Other (Specify below) [x] Irrigation [] Industrial [] Domestic-lawn & garden [] Monitoring well Was a chemical/bacteriological sample submitted to Department? [] Yes [] No If yes, mo/day/yr sample was submitted Water well disinfected? [] Yes [] No

5 TYPE OF CASING USED: [x] Steel [] PVC [] Other CASING JOINTS: [] Glued [] Clamped [x] Welded [] Threaded Casing diameter .16 in. to ft., Diameter in. to ft., Diameter in. to ft. Casing height above land surface in., Weight lbs./ft., Wall thickness or gauge No. TYPE OF SCREEN OR PERFORATION MATERIAL: [x] Steel [] Stainless Steel [] PVC [] Brass [] Galvanized Steel [] None used (open hole) [] Other (Specify) SCREEN OR PERFORATION OPENINGS ARE: [] Continuous slot [] Mill slot [] Gauze wrapped [x] Torch cut [] Drilled holes [] None (open hole) [] Louvered shutter [] Key punched [] Wire wrapped [] Saw cut [] Other (specify) SCREEN-PERFORATED INTERVALS: From ft. to ft., From ft. to ft., From ft. to ft. GRAVEL PACK INTERVALS: From ft. to ft., From ft. to ft., From ft. to ft.

6 GROUT MATERIAL: [] Neat cement [] Cement grout [] Bentonite [] Other Grout Intervals: From ft. to ft., From ft. to ft., From ft. to ft. What is the nearest source of possible contamination: [] Septic tank [] Lateral lines [] Pit privy [] Livestock pens [] Insecticide storage [] Other (specify below) [] Sewer lines [] Cesspool [] Sewage lagoon [] Fuel storage [] Abandoned water well [] Watertight sewer lines [] Seepage pit [] Feedyard [] Fertilizer storage [] Oil well/gas well Direction from well Distance from well

FROM	TO	LITHOLOGIC LOG	FROM	TO	LITHO. LOG (cont.) or PLUGGING INTERVALS
		THIS WELL CONVERTED FROM			
		IRRIGATION TO DOMESTIC USE			

7 CONTRACTOR'S OR LANDOWNER'S CERTIFICATION: This water well was [] constructed, [x] reconstructed, or [] plugged under my jurisdiction and was completed on (mo/day/year) 11-01-2013 and this record is true to the best of my knowledge and belief. Kansas Water Well Contractor's License No. 722 This Water Well Record was completed on (mo/day/year) 01-24-2014 under the business name of WESTERN SPRINKLERS, INC by (signature) Paul Miller 1-24-14

INSTRUCTIONS: Use typewriter or ball point pen. PLEASE PRESS FIRMLY and PRINT clearly. Please fill in blanks and check the correct answers. Send one copy to Kansas Department of Health and Environment, Bureau of Water, Geology Section, 1000 SW Jackson St., Suite 420, Topeka, Kansas 66612-1367. Telephone 785-296-5524. Send one copy to WATER WELL OWNER and retain one for your records. Include fee of \$5.00 for each constructed well. Visit us at <http://www.kdheks.gov/waterwell/index.html>

No Fee required per Richard Harper 785-296-3565 1-27-2014