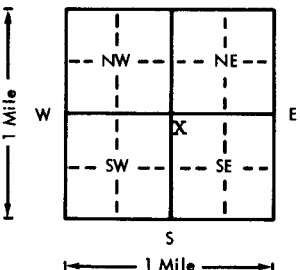


USE TYPEWRITER OR BALL POINT PEN-PRESS FIRMLY, PRINT CLEARLY.

WATER WELL RECORD
KSA 82a-1201-1215

Kansas Department of Health and Environment-Division of Environment (Water well Contractors) Topeka, Kansas 66620

1. Location of well:		County Stanton	Fraction NW 1/4 NW 1/4 SE 1/4	Section number 14	Township number T 29 S R 39	Range number E/W
2. Distance and direction from nearest town or city: 3 miles south, 1/2 mile east. Street address of well location if in city:			3. Owner of well: Joe Byer R.R. or street: 707 N. Durham City, state, zip code: Ulysses, Ks. 67880			
4. Locate with "X" in section below: Sketch map: 			6. Bore hole dia. <u>27</u> in. Completion date _____ Well depth <u>554</u> ft. <u>4-17-76</u>			
5. Type and color of material			From		To	
Surface			0		2°	
Very fine to fine sand w/clay breakers			2		65	
Medium to coarse sand w/clay breakers			65		108	
Brown gummy clay w/medium sand strips			108		214	
Fine to medium sand w/clay breakers			214		227	
Brown sandy clay			227		256	
Brown sandy clay w/medium sand strips			256		289	
Medium to coarse sand w/clay breakers			289		348	
Brown sandy caly w/medium sand strips			348		355	
Very fine to fine sand w/sandy clay strips			355		388	
Medium to coarse sand w/clay breakers			388		399	
Cemented sand			399		403	
Brown shale & sandy clay tight			403		422	
Yellow chalk, sandrock & Dakota			422		472	
Yellow chalk, sandrock & Cheyenne			472		512	
Brown shale, sandrock, Dakota & Cheyenne			512		554	
(Use a second sheet if needed)						
18. Elevation:		19. Remarks:		20. Water well contractor's certification:		
Topography: <input type="checkbox"/> Hill <input checked="" type="checkbox"/> Slope <input type="checkbox"/> Upland <input type="checkbox"/> Valley		40 feet of Johnson Screen set between 291.6 feet and 331.6 feet.		This well was drilled under my jurisdiction and this report is true to the best of my knowledge and belief. Houck Bros. Drlg. Co. 164 Business name License No. Address Box 487, Ulysses, Ks. Signed M. Beard Date 4-30-76 Authorized representative		

29
 39E
 14
 Sec
 1/4
 1/4
 1/4
 1/4
 MURPHY