USE TYPEWRITER OR BALL POINT PEN-PRESS FIRMLY, PRINT CLEARLY.

T R EW sec 1/4 1/4 1/4 No.

WATER WELL RECORD
KSA 82a-1201-1215

Kansas State Dept. Of Health
(Water Well Contractors)
Forbes-Bldg. 740
Topeka, Kansas 66620

1 Location of well:	County	Township name	Fraction	Section number	Town number	Range number
	Stanton	Big Bow	SW¼, SW¼, NW¼	20	T29S	R39W

Distance and direction from nearest town or city:
7 Mi. East of Johnson - 4 1/2 Mi. South on east side of road
Street address of well location if in city:

3 Owner of well: Leon Kilgore
Address: Johnson. Kansas 67855

Locate with "X" in section below:

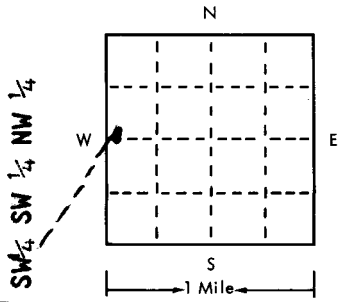

Sketch map:

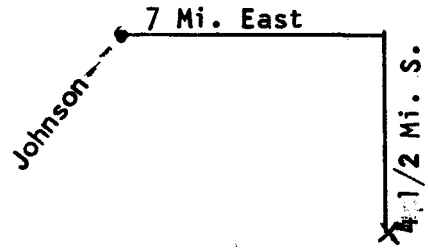

4 Well depth: 412 ft. Date of completion 6-19-75
Well diameter 26 in.

5 ☐ Cable tool ☐ Rotary ☐ Driven ☐ Dug
☐ Hollow rod ☐ Jetted ☐ Bored ☒ Reverse rotary

6 Use: ☐ Domestic ☐ Public supply ☐ Industry
☒ Irrigation ☐ Air conditioning ☐ Commercial
☐ Test well ☐

7 Casing: Material steel Height: above/~~below~~
Threaded ☐ Welded ☒ Surface 12 in.
Diam. 16 in. to 412 ft. depth Weight 34¼ lbs./ft.
___ in. to ___ ft. depth Drive shoe? ☐ Yes ☒ No

2 Type and color of material	From	To
Test Not Available		
Drilled close to old location.		
(use a second sheet if needed)		

8 Screen:
Manufacturer Lakewood
Type Steel Dia. 16"
Slot/~~gauze~~ .125x66 Length 185
Set between 227 ft. and 412 ft.
Fittings:
Gravel pack ☒ Yes ☐ No Size range of material ⅛ down

9 Static water level:
190 ft. below land surface Date 6-1-75

10 Pumping level below land surfaces:
225 ft. after 5 hrs. pumping 1300 g.p.m.
___ ft. after ___ hrs. pumping ___ g.p.m.
Estimated maximum yield 1600 g.p.m.

11 Water sample submitted:
☐ Yes ☒ No Date ___

12 Well head completion: 12"
☐ Pitless adapter ☒ Inches above grade

13 Well grouted? ☒ Yes ☐ No Customer Ran
☒ Neat cement ☒ Bentonite ☐
Depth: From 0 ft. to 10 ft.

14 Nearest source of possible contamination: in field
ft. ___ Direction none Type ___
Well disinfected upon completion? ☐ Yes ☒ No

15 Pump: ☐ Not installed
Manufacturer's name Goulds
Model number ___ HP 150 Volts ___
Length of drop pipe 280 ft. capacity 1600 g.m.p.
Type:
☐ Submersible ☒ Turbine
☐ Jet ☐ Reciprocating
☐ Certrifugal ☐ Other

16 Remarks: elevation
Drilling Sub-Contracted to
Minter-Wilson Drilling Co.
Garden City, Kan. License #208

Topography:
☐ Hill
☒ Slope
☐ Upland
☐ Valley

17 Water well contractor's certification:
This well was drilled under my jurisdiction and this report is true to the best of my knowledge and belief.
K. I. Drilling Co. 263
Business name License No.
Address Box 669, Ulysses, Kan.
Signed [signature] Date 6-19-75
Authorized representative

Forward the white, blue and pink copies to the Kansas State Dept. Of Health.

Form WWC-5