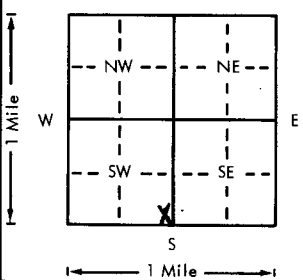


USE TYPEWRITER OR BALL POINT PEN-PRESS FIRMLY, PRINT CLEARLY.

WATER WELL RECORD
KSA 82a-1201-1215

Kansas Department of Health and Environment-Division of Environment
(Water well Contractors)
Topeka, Kansas 66620

1. Location of well:	County Stanton	Fraction SE 1/4 SE 1/4 SW 1/4	Section number 22	Township number T 29 S R 39	Range number 39
2. Distance and direction from nearest town or city: 4 south of RR track at Big Bow, Ks. and 1/2 mile west			3. Owner of well: Ronald Snowbarger R.R. or street: RFD 2 City, state, zip code: Johnson, Ks. 67855		
4. Locate with "X" in section below: 			6. Bore hole dia. 9 1/4 in. Completion date _____ Well depth 397 ft. 9/13/78		
5. Type and color of material			7. <input type="checkbox"/> Cable tool <input checked="" type="checkbox"/> Rotary <input type="checkbox"/> Driven <input type="checkbox"/> Dug <input type="checkbox"/> Hollow rod <input type="checkbox"/> Jetted <input type="checkbox"/> Bored <input type="checkbox"/> Reverse rotary		
Surface			8. Use: <input checked="" type="checkbox"/> Domestic <input type="checkbox"/> Public supply <input type="checkbox"/> Industry <input type="checkbox"/> Irrigation <input type="checkbox"/> Air conditioning <input type="checkbox"/> Stock <input type="checkbox"/> Lawn <input type="checkbox"/> Oil field water <input type="checkbox"/> Other		
Clay			9. Casing: Material styrene Height: <input checked="" type="checkbox"/> Above or below glued and riveted <input type="checkbox"/> Surface 18 in. Threaded <input type="checkbox"/> Welded _____ RMP _____ PVC _____ Weight _____ lbs./ft. Dia. 5 in. to 367 ft. depth Wall Thickness: inches or Dia. _____ in. to _____ ft. depth gage No. 320		
Clay and lime			10. Screen: Manufacturer's name _____ Sunflower Type styrene Dia. 5" Slot/gauze 1/16" Length 30 Set between 367 ft. and 397 ft. _____ ft. and _____ ft.		
Medium sand			11. Static water level: _____ mo./day/yr. 160 ft. below land surface Date 9-18-78		
Brown clay			12. Pumping level below land surfaces: 170 ft. after 6 hrs. pumping 15 g.p.m. _____ ft. after _____ hrs. pumping _____ g.p.m. Estimated maximum yield 30 g.p.m.		
Fine to medium sand w/clay			13. Water sample submitted: _____ mo./day/yr. <input type="checkbox"/> Yes <input checked="" type="checkbox"/> No Date _____		
Gray and brown clay			14. Well head completion: <input checked="" type="checkbox"/> Pitless adapter 18 Inches above grade		
Sandy clay and fine sand			15. Well grouted? <input checked="" type="checkbox"/> With: <input checked="" type="checkbox"/> Neat cement <input type="checkbox"/> Bentonite <input type="checkbox"/> Concrete Depth: From 0 ft. to 10 ft.		
Fine to coarse sand w/small clay breakers			16. Nearest source of possible contamination: ft. _____ Direction _____ Type field Well disinfected upon completion? <input checked="" type="checkbox"/> Yes <input type="checkbox"/> No		
Sandy clay w/sand strips			17. Pump: <input checked="" type="checkbox"/> Not installed Manufacturer's name _____ Model number _____ HP _____ Volts _____ Length of drop pipe _____ ft. capacity _____ g.p.m. Type: <input type="checkbox"/> Submersible <input type="checkbox"/> Turbine <input type="checkbox"/> Jet <input type="checkbox"/> Reciprocating <input type="checkbox"/> Centrifugal <input type="checkbox"/> Other		
Tight clay w/sand strips			20. Water well contractor's certification: This well was drilled under my jurisdiction and this report is true to the best of my knowledge and belief. Houck Bros. Dglg. Co. 164 Business name _____ license No. _____ Address Box 487, Ulysses, Ks. Signed M. Beard Date 10/6/78 Authorized representative		
Medium to coarse sand					
Tight clay					
Coarse sand					
(Use a second sheet if needed)					
18. Elevation:		19. Remarks:			
Topography: <input type="checkbox"/> Hill <input checked="" type="checkbox"/> Slope <input type="checkbox"/> Upland <input type="checkbox"/> Valley		drilled in field for a new home nothing else there.			

T 29 S R 39
 Sec 22
 1/4 1/4
 SE 1/4 SW 1/4