


USE TYPEWRITER OR BALL POINT PEN-PRESS FIRMLY, PRINT CLEARLY.

WATER WELL RECORD  
KSA 82a-1201-1215

Kansas Department of Health and Environment-Division of Environment  
(Water well Contractors)  
Topeka, Kansas 66620

1. Location of well: County Stanton Section SE 1/4 NW 1/4 SW 1/4 Township number 24 Range number 29 S R 39 E/W

2. Distance and direction from nearest town or city: 2 S, 2 E, 1 1/2 S 3. Owner of well: Don Ruth  
Street address of well location if in city: of Big Barn, Ks. R.R. or street: Route  
City, state, zip code: Johnson, Ks.

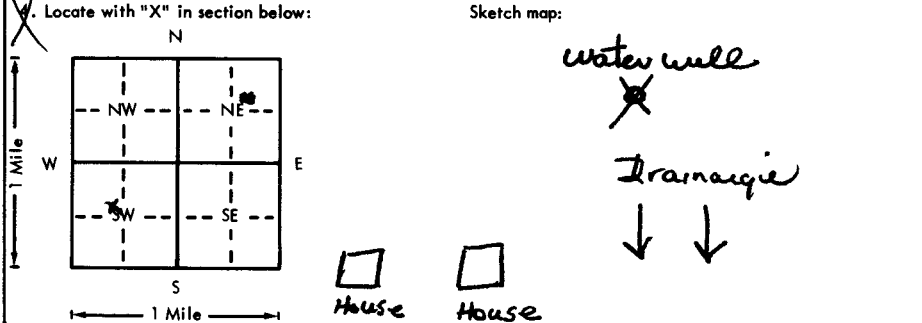

6. Bore hole dia. 9 1/2 in. Completion date 9-10-76  
Well depth 315 ft.

7. Cable tool  Rotary  Driven  Dug  
 Hollow rod  Jetted  Bored  Reverse rotary

8. Use:  Domestic  Public supply  Industry  
 Irrigation  Air conditioning  Stock  
 Lawn  Oil field water  Other

9. Casing: Material PTS Height: Above or below  
Threaded  Welded  Surface 18 in.  
RMP  PVC  Weight  lbs./ft.  
Dia. 0 in. to 36 ft. depth Wall Thickness: inches or  
Dia.  in. to  ft. depth Gauge No. 0320

5. Type and color of material	From	To
<u>Surface + fine sand</u>	<u>0</u>	<u>20</u>
<u>Brown clay</u>	<u>20</u>	<u>80</u>
<u>Sand</u>	<u>80</u>	<u>100</u>
<u>Brown clay</u>	<u>100</u>	<u>120</u>
<u>Sand</u>	<u>120</u>	<u>140</u>
<u>Brown + Blue clay</u>	<u>140</u>	<u>160</u>
<u>Sand</u>	<u>160</u>	<u>220</u>
<u>Brown clay</u>	<u>220</u>	<u>240</u>
<u>Sand + Brown clay strips</u>	<u>240</u>	<u>260</u>
<u>Brown clay</u>	<u>260</u>	<u>280</u>
<u>Coarse Sand</u>	<u>280</u>	<u>315</u>

10. Screen: Manufacturer's name Sunflow  
Plastic Pipe, Inc.  
Type Styro Dia. 5"  
5/16 gauge 0.61 (1/16) Length 40  
Set between 0-275 ft. and 275-315 ft.  
ft. and  ft.  
Gravel pack?  Size range of material 1/4 x 1/8

11. Static water level: 9-10-76 mo./day/yr.  
130 ft. below land surface Date           

12. Pumping level below land surfaces: N.A.  
       ft. after        hrs. pumping        g.p.m.  
       ft. after        hrs. pumping        g.p.m.  
Estimated maximum yield        g.p.m.

13. Water sample submitted: N.A. mo./day/yr.  
 Yes  No Date           

14. Well head completion:  
 Pitless adapter 18 Inches above grade

15. Well grouted? yes  
With:  Neat cement  Bentonite  Concrete  
Depth: From 6 ft. to 20 ft.

16. Nearest source of possible contamination:  
ft. 200 Direction SW Type Gas Tank  
Well disinfected upon completion?  Yes  No

17. Pump: Not installed  
Manufacturer's name Goulds  
Model number        HP 2 Volts 230  
Length of drop pipe 200 ft. capacity 1000 g.p.m.  
Type:  
 Submersible  Turbine  
 Jet  Reciprocating  
 Centrifugal  Other

18. Elevation: Topography:  Hill  Slope  Upland  Valley  
19. Remarks: Concrete slab to be installed by owner.

20. Water well contractor's certification: 255  
This well was drilled under my jurisdiction and this report is true to the best of my knowledge and belief.  
Wagner Drig. 255  
Business name License No.  
Address Albesses Ks.  
Signed Diagne Wagner Date 9-28-76  
Authorized representative

T 29 R 39 E 24 Sec 31/4 SE 1/4 SW 1/4