USE TYPEWRITER OR BALL POINT PEN-PRESS FIRMLY, PRINT CLEARLY.

WATER WELL RECORD
KSA 82a-1201-1215

Kansas Department of Health and Environment-Division of Environment
(Water well Contractors)
Topeka, Kansas 66620

1. Location of well:	County	Fraction	Section number	Township number	Range number
	SEDGWICK	1/4 SE 1/4 SE 1/4	16	T 29 S	R 4W E/W

2. Distance and direction from nearest town or city: 3/4 miles E. of 375th St. W. on 95th St. So. then
Street address of well location if in city:

3. Owner of well: Charles Shelton
R.R. or street: 2026 Munnel
City, state, zip code: Wichita, Kansas

4. Locate with "X" in section below:

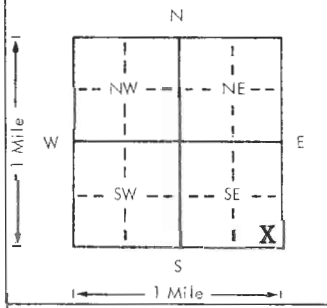

Sketch map:
1/8 mile No. on the driveway.
Viola, Kansas

6. Bore hole dia. 11 in. Completion date
Well depth 65 ft. 5-10-78

7. __ Cable tool X Rotary __ Driven __ Dug
__ Hollow rod __ Jetted __ Bored __ Reverse rotary

8. Use: __ Domestic __ Public supply __ Industry
__ Irrigation __ Air conditioning X Stock
__ Lawn __ Oil field water __ Other

9. Casing: Material styrene Height: Above or below
Threaded __ Welded gl Surface 12 in.
RMP X PVC __ Weight __ lbs./ft.
Dia. 5 in. to 65 ft. depth Wall Thickness: inches or
Dia. __ in. to __ ft. depth gage No. .200

5. Type and color of material	From	To
Sandy Topsoil	0	3
Red Clay	3	12
Red Shale	12	65
(Use a second sheet if needed)		

10. Screen: Manufacturer's name Sunflower Plastic
Type styrene Dia. 5"
Slot/gauge .06 Length 45'
Set between 20 ft. and 65 ft.
ft. and ft.
Gravel pack? yes Size range of material 1/4-1/8"

11. Static water level: mo./day/yr.
18 ft. below land surface Date 5-10-78

12. Pumping level below land surfaces:
ft. after hrs. pumping g.p.m.
ft. after hrs. pumping g.p.m.
Estimated maximum yield g.p.m.

13. Water sample submitted: mo./day/yr.
__ Yes __ No Date

14. Well head completion: capped
__ Pitless adapter 12 Inches above grade

15. Well grouted? yes 1-2Fine Sand Mix
With: __ Neat cement __ Bentonite X Concrete
Depth: From 0 ft. to 10 ft.

16. Nearest source of possible contamination: septic
ft. 200 Direction East Type tank
Well disinfected upon completion? X Yes __ No

17. Pump: X Not installed
Manufacturer's name
Model number HP Volts
Length of drop pipe ft. capacity g.p.m.
Type:
__ Submersible __ Turbine
__ Jet __ Reciprocating
__ Centrifugal __ Other

18. Elevation:

Topography:
__ Hill
__ Slope
__ Upland
__ Valley

19. Remarks: Flat Ground

20. Water well contractor's certification:
This well was drilled under my jurisdiction and this report is true to the best of my knowledge and belief.
Harp Well & Pump 236
Business name License No.
Address Wichita, Kansas 67209
Signed M. Arnold Date 6-29-78
Authorized representative

29 T 4 R E W 16 Sec SE 1/4 SE 1/4 SE 1/4

Forward the white, blue and pink copies to the Department of Health and Environment

Form WWC-5