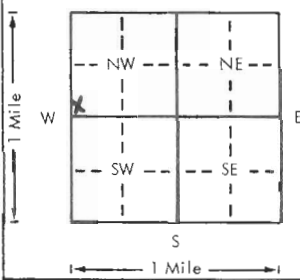


USE TYPEWRITER OR BALL
POINT PEN-PRESS FIRMLY,
PRINT CLEARLY.

WATER WELL RECORD
KSA 82a-1201-1215

Kansas Department of Health and
Environment-Division of Environment
(Water well Contractors)
Topeka, Kansas 66620

1. Location of well:	County Sedgwick	Fraction 1/4 SW 1/4 NW 1/4	Section number 16	Township number T 29 S	Range number R 4W E/W
2. Distance and direction from nearest town or city: 6 1/2 South of McArthur on			3. Owner of well: William Ruckle		
Street address of well location if in city: 375th West on the east			R.R. or street: R. R. #1		
			City, state, zip code: Milton, Kansas		
4. Locate with "X" in section below: 			Sketch map: side of the road. Cheney, Ks.		
5. Type and color of material			6. Bore hole dia. 11 in. Completion date 10-15-77 Well depth 70 ft.		
			7. ☒ Cable tool ☒ Rotary ☐ Driven ☐ Dug ☐ Hollow rod ☐ Jetted ☐ Bored ☐ Reverse rotary		
			8. Use: ☒ Domestic ☐ Public supply ☐ Industry ☐ Irrigation ☐ Air conditioning ☐ Stock ☐ Lawn ☐ Oil field water ☐ Other		
			9. Casing: Material styrene Height: Above or below Threaded ☐ Welded ☐ 81 Surface 12 in. RMP ☒ PVC ☐ Weight ☐ lbs./ft. Dia. 5 in. to 70 ft. depth Wall Thickness: inches or Dia. ☐ in. to ☐ ft. depth gage No. .200		
			10. Screen: Manufacturer's name Sunflower Plastic Type styrene Dia. 5" Slot/gauge 06 Length 40" Set between 30 ft. and 70 ft. ft. and ☐ ft. Gravel pack? yes Size range of material 1/4-1/8"		
(Use a second sheet if needed)			11. Static water level: ☐ mo./day/yr. 30 ft. below land surface Date 10-15-77		
			12. Pumping level below land surfaces: ft. after ☐ hrs. pumping ☐ g.p.m. ft. after ☐ hrs. pumping ☐ g.p.m. Estimated maximum yield ☐ g.p.m.		
			13. Water sample submitted: ☐ mo./day/yr. ☐ Yes ☐ No Date ☐		
			14. Well head completion: capped ☐ Pitless adapter 12 inches above grade		
			15. Well grouted? yes 1-2 fine sand mix With: ☐ Neat cement ☐ Bentonite ☒ Concrete Depth: From 40" ft. to 14 ft.		
			16. Nearest source of possible contamination: Septic ft. 150 Direction West Type Tank Well disinfected upon completion? ☒ Yes ☐ No		
			17. Pump: ☒ Not installed Manufacturer's name ☐ Model number ☐ HP ☐ Volts ☐ Length of drop pipe ☐ ft. capacity ☐ g.p.m. Type: ☐ Submersible ☐ Turbine ☐ Jet ☐ Reciprocating ☐ Centrifugal ☐ Other		
			20. Water well contractor's certification: This well was drilled under my jurisdiction and this report is true to the best of my knowledge and belief. Harp Well & Pump 236 Business name Wichita, Kansas 67209 License No. Address M. Arnold Signed M. Arnold Date 10-17-77 Authorized representative		
			18. Elevation:		
			19. Remarks: Flat Ground		

Forward the white, blue and pink copies to the Department of Health and Environment

Form WWC-5