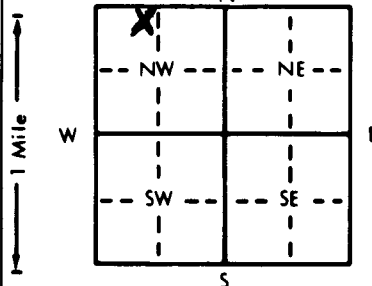


1 LOCATION OF WATER WELL: County: STANTON	Fraction NE ¼ NW ¼ NW ¼	Section Number 18	Township Number T 29 S	Range Number R 40W E 1W
---	----------------------------	-----------------------------	----------------------------------	--

Distance and direction from nearest town or city street address of well if located within city?

FROM JOHNSON CITY: 3 SOUTH, 1.2 EAST & SOUTH INTO LOC.

2 WATER WELL OWNER: BECKER OIL RR#, St. Address, Box # : 212 FIRST NATIONAL BANK BLDG. City, State, ZIP Code : PONCA CITY, OK 74001	#1 <i>Essex</i> Board of Agriculture, Division of Water Resources Application Number: 960060
--	---

3 LOCATE WELL'S LOCATION WITH AN "X" IN SECTION BOX: 	4 DEPTH OF COMPLETED WELL: 460 ft. ELEVATION: Depth(s) Groundwater Encountered 1. 235 ft. 2. ft. 3. ft. WELL'S STATIC WATER LEVEL 235 ft. below land surface measured on mo/day/yr 02-13-96 Pump test data: Well water was 255 ft. after 1 hours pumping 100 gpm Est. Yield 100 gpm: Well water was ft. after hours pumping gpm Bore Hole Diameter 11 in. to 460 ft., and in. to ft. WELL WATER TO BE USED AS: 5 Public water supply 8 Air conditioning 11 Injection well 1 Domestic 3 Feedlot 6 Oil field water supply 9 Dewatering 12 Other (Specify below) 2 Irrigation 4 Industrial 7 Lawn and garden only 10 Monitoring well Was a chemical/bacteriological sample submitted to Department? Yes No X ; If yes, mo/day/yr sample was submitted Water Well Disinfected? Yes X No
--	---

5 TYPE OF BLANK CASING USED: 1 Steel 3 RMP (SR) 2 PVC 4 ABS Blank casing diameter 6 in. to 460 ft., Dia. in. to ft., Dia. in. to ft. Casing height above land surface 24 in., weight 2.902 lbs./ft. Wall thickness or gauge No. 280 SDR 21	5 Wrought iron 8 Concrete tile CASING JOINTS: Glued X Clamped 6 Asbestos-Cement 9 Other (specify below) Welded 7 Fiberglass Threaded
TYPE OF SCREEN OR PERFORATION MATERIAL: 1 Steel 3 Stainless steel 5 Fiberglass 2 Brass 4 Galvanized steel 6 Concrete tile SCREEN OR PERFORATION OPENINGS ARE: 1 Continuous slot 3 Mill slot 5 Gauzed wrapped 2 Louvered shutter 4 Key punched 6 Wire wrapped 7 Torch cut	7 PVC 10 Asbestos-cement 8 RMP (SR) 11 Other (specify) 9 ABS 12 None used (open hole) 8 Saw cut 11 None (open hole) 9 Drilled holes 10 Other (specify)
SCREEN-PERFORATED INTERVALS: From 380 ft. to 460 ft., From ft. to ft. From ft. to ft., From ft. to ft. GRAVEL PACK INTERVALS: From 280 ft. to 460 ft., From ft. to ft. From ft. to ft., From ft. to ft.	

6 GROUT MATERIAL: 1 Neat cement 2 Cement grout 3 Bentonite 4 Other HOLE PLUG Grout Intervals: From 0 ft. to 16 ft., From ft. to ft., From ft. to ft. What is the nearest source of possible contamination: 1 Septic tank 4 Lateral lines 7 Pit privy 10 Livestock pens 14 Abandoned water well 2 Sewer lines 5 Cess pool 8 Sewage lagoon 11 Fuel storage 15 Oil well/Gas well 3 Watertight sewer lines 6 Seepage pit 9 Feedyard 12 Fertilizer storage 16 Other (specify below) 13 Insecticide storage Direction from well? South How many feet? 150
--

FROM	TO	LITHOLOGIC LOG	FROM	TO	PLUGGING INTERVALS
0	38	SANDY CLAY	442	460	CLAY YELLOW
38	104	SAND & GRAVEL			
104	114	CLAY			
114	134	SANDY CLAY & CLAY			
134	146	SAND			
146	154	SANDY CLAY			
154	191	SAND & CLAY STREAKS			
191	203	CLAY & SAND STREAKS			
203	253	SAND & CLAY STREAKS			
253	291	SAND & GRAVEL			
291	322	GRAVEL & CLAY MIX			
322	336	SANDY CLAY & COARSE SAND STREAKS			
336	344	COARSE SAND			
344	358	CLAY & GRAVEL MIX			
358	442	SAND & CLAY STREAKS			

7 CONTRACTOR'S OR LANDOWNER'S CERTIFICATION: This water well was (1) constructed, (2) reconstructed, or (3) plugged under my jurisdiction and was completed on (mo/day/year) 02-13-96 and this record is true to the best of my knowledge and belief. Kansas Water Well Contractor's License No. KWCL-430 This Water Well Record was completed on (mo/day/yr) 02-13-96 under the business name of HOWARD DRUG CO. BOX 806 BEAVER, OK 73932 by (signature) <i>[Signature]</i>
