

# WATER WELL PLUGGING RECORD Form WWC-5P

KSA 82a-1212

ID NO.

21,038

|   |  |                      |                           |   |
|---|--|----------------------|---------------------------|---|
| <b>1 LOCATION OF WATER WELL:</b><br>County: STANTON | Fraction<br>$\frac{1}{4}$ $\frac{1}{4}$ $\frac{1}{4}$ SE $\frac{1}{4}$ | Section Number<br>10 | Township Number<br>T 29 S | Range Number<br>40 <input type="checkbox"/> E <input checked="" type="checkbox"/> W |
|---|--|----------------------|---------------------------|---|

Street/Rural Address of Well Location; if unknown, distance & direction from nearest town or intersection: If at owner's address, check here ☐ From Big Bow Grade, 6 miles west,

2 miles south, 1/2 mile west and approx. 800' south

## Global Positioning Systems (GPS) information:

Latitude: 37.53869 N (in decimal degrees)

Longitude: 101.68052 W (in decimal degrees)

Elevation:

Datum: ☐ WGS84, ☐ NAD83, ☒ NAD27

Collection Method:


☒ GPS unit (Make/Model: Magellan eXplorist GC

☐ Digital Map/Photo, ☐ Topographic Map, ☐ Land Survey

Est. Accuracy: ☐ < 3 m, ☐ 3-5 m, ☐ 5-15 m, ☐ > 15 m

**2 WATER WELL OWNER:** John Nelson Freedom Farms  
RR#, St. Address, Box #: P.O. Box 702  
City, State ZIP Code: Johnson Ks., 67855

## 3 MARK WELL'S LOCATION WITH AN "X" IN SECTION BOX:

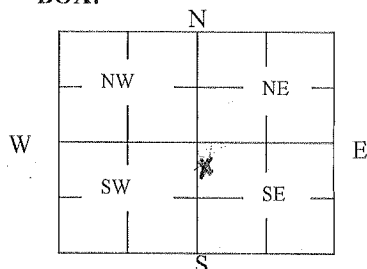

**4 DEPTH OF WELL** 371' ft.

WELL'S STATIC WATER LEVEL No Water ft

WELL WAS USED AS:

☒ Domestic  
☐ Irrigation  
☐ Feedlot  
☐ Industrial

☐ Public Water Supply  
☐ Oil Field Water Supply  
☐ Domestic (Lawn & Garden)  
☐ Air Conditioning

☐ Dewatering  
☐ Monitoring  
☐ Injection Well  
☐ Other

Was a chemical/bacteriological sample submitted to Department? Yes ☐ No ☒

## 5 TYPE OF BLANK CASING USED:

☒ Steel ☐ RMP (SR) ☐ Wrought ☐ Fiberglass ☐ Other (Specify below)  
☐ PVC ☐ ABS ☐ Asbestos-Cement ☐ Concrete Tile

Blank casing diameter 16" in. Was casing pulled? Yes ☒ No ☐ If yes, how much 60"  
Casing height above or below land surface Below 60" in.

## 6 GROUT PLUG MATERIAL:

☐ Neat cement ☒ Cement grout ☐ Bentonite ☐ Other

Grout Plug Intervals: From 10' ft. to 5' ft., From ft. to ft., From to ft.

What is the nearest source of possible contamination:

☐ Septic tank  
☐ Sewer lines  
☐ Watertight sewer lines  
☐ Lateral lines  
☐ Cess pool

☐ Seepage pit  
☐ Pit privy  
☐ Sewage lagoon  
☐ Feedyard  
☐ Livestock pens

☐ Fuel Storage  
☐ Fertilizer storage  
☐ Insecticide storage  
☐ Abandoned water well  
☐ Oil well/Gas well

☒ Other (specify below)  
None Observed

Direction from well?   
How many feet?

| FROM | TO  | PLUGGING MATERIALS            | FROM | TO | PLUGGING MATERIALS |
|------|-----|-------------------------------|------|----|--------------------|
| 371' | 10' | Oversized rock w/clay chunks  | 10'  | 5' | 3,000 PSI Concrete |
| 5'   | 0'  | Cut off casing and backfilled |      |    |                    |
|      |     |                               |      |    |                    |
|      |     |                               |      |    |                    |
|      |     |                               |      |    |                    |
|      |     |                               |      |    |                    |

**7 CONTRACTOR'S OR LANDOWNER'S CERTIFICATION:** This water well was plugged under my jurisdiction and was completed on (mo/day/year) 3/13/2013 and this record is true to the best of my knowledge and belief. Kansas Water Well Contractor's License No. 145. This Water Well Record was completed on (mo/day/year) 4/4/2013 under the business name of Hydro Resources Mid Continent by (signature) Gary Clepper

**INSTRUCTIONS:** Use typewriter or ballpoint pen. Please press firmly and print clearly. Please fill in blanks, underline or circle the correct answers. Send top three copies to Kansas Department of Health and Environment, Bureau of Water, Geology Section, 1000 SW Jackson St., Ste. 420, Topeka, Kansas 66612-1367. Telephone: 785/296-5524. Send one to Water Well Owner and retain one for your records. Visit us at <http://www.kdheks.gov/waterwell/index.html>.

Check one: ☐ White Copy ☐ Blue Copy ☐ Pink Copy