WATER WELL RECORD Form WWC-5 KSA 82a-1212

1 LOCATION OF WATER WELL: County: Stanton | Fraction: NW ¼ NE ¼ SW ¼ | Section Number: 7 | Township Number: T 29 S | Range Number: R 40 E W

Distance and direction from nearest town or city street address of well if located within city?
2 Miles South, 1½ mile East 1/4 Mile North of Johnson City, Ks.

2 WATER WELL OWNER: Keith Gasgill
RR#, St. Address, Box # : 542 Clayton
City, State, ZIP Code : Grand Prairie, Texas 75052

Murfin Drilling, Inc.
Box 661, Colby, Ks. 67701

Board of Agriculture, Division of Water Resources
Application Number: 940163

3 LOCATE WELL'S LOCATION WITH AN "X" IN SECTION BOX:

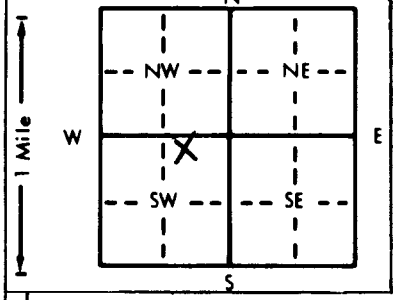

4 DEPTH OF COMPLETED WELL 379 ft. ELEVATION:
Depth(s) Groundwater Encountered 1. ft. 2. ft. 3. ft.
WELL'S STATIC WATER LEVEL 297 ft. below land surface measured on mo/day/yr
Pump test data: Well water was ft. after hours pumping gpm
Est. Yield gpm: Well water was ft. after hours pumping gpm
Bore Hole Diameter 8 in. to 379 ft., and in. to ft.
WELL WATER TO BE USED AS: 5 Public water supply 8 Air conditioning 11 Injection well
1 Domestic 3 Feedlot 6 Oil field water supply 9 Dewatering 12 Other (Specify below)
2 Irrigation 4 Industrial 7 Lawn and garden only 10 Monitoring well
Was a chemical/bacteriological sample submitted to Department? Yes No X; If yes, mo/day/yr sample was submitted Water Well Disinfected? Yes No X

5 TYPE OF BLANK CASING USED: 5 Wrought iron 8 Concrete tile CASING JOINTS: Glued X Clamped
1 Steel 3 RMP (SR) 6 Asbestos-Cement 9 Other (specify below) Welded
2 PVC 4 ABS 7 Fiberglass Threaded
Blank casing diameter 4.5 in. to 319 ft., Dia in. to ft., Dia in. to ft.
Casing height above land surface 18 in., weight 2.38 lbs./ft. Wall thickness or gauge No. .248

TYPE OF SCREEN OR PERFORATION MATERIAL: 7 PVC 10 Asbestos-cement
1 Steel 3 Stainless steel 5 Fiberglass 8 RMP (SR) 11 Other (specify)
2 Brass 4 Galvanized steel 6 Concrete tile 9 ABS 12 None used (open hole)

SCREEN OR PERFORATION OPENINGS ARE: 5 Gauzed wrapped 8 Saw cut 11 None (open hole)
1 Continuous slot 3 Mill slot 6 Wire wrapped 9 Drilled holes
2 Louvered shutter 4 Key punched 7 Torch cut 10 Other (specify)

SCREEN-PERFORATED INTERVALS: From 319 ft. to 379 ft., From ft. to ft.
From ft. to ft., From ft. to ft.
GRAVEL PACK INTERVALS: From 20 ft. to 379 ft., From ft. to ft.
From ft. to ft., From ft. to ft.

6 GROUT MATERIAL: 1 Neat cement 2 Cement grout 3 Bentonite 4 Other
Grout Intervals: From 0 ft. to 20 ft., From ft. to ft., From ft. to ft.

What is the nearest source of possible contamination:
1 Septic tank 4 Lateral lines 7 Pit privy 10 Livestock pens 14 Abandoned water well
2 Sewer lines 5 Cess pool 8 Sewage lagoon 11 Fuel storage 15 Oil well/Gas well
3 Watertight sewer lines 6 Seepage pit 9 Feedyard 12 Fertilizer storage 16 Other (specify below)
13 Insecticide storage
Direction from well? Northwest How many feet? 150'

FROM	TO	LITHOLOGIC LOG	FROM	TO	PLUGGING INTERVALS
0	2	Surface	198	200	Sandy Clay w/Sand Strks.
2	10	Loess	200	246	Med. Sand & Gravel w/Clay St.
10	13	Clay	246	247	Caliche
13	80	Sandy Clay w/Caliche	247	258	Med. Sand & Gravel
80	95	Sandy Clay w/Caliche & Some	258	259	Sandy Clay
95	107	Fine Sand w/Clay Str.Sand St	259	261	Med. Sand & Gravel w/Clay St
107	115	Med. Sand w/Clay St.	261	278	Sandy Clay & Caliche
115	123	Sand & Clay/Sand Strks.	278	282	Sand
123	130	Sandy Clay w/Caliche Strks.	282	315	Med. Sand & Clay
130	135	Sand	315	337	Sticky Sandy Clay
135	150	Sandy Clay w/Caliche Strks.	337	342	Med. Sand w/Clay Strks.
150	160	Sandy Clay w/Med. Sand	342	352	Sticky Clay w/Sand Strks.
160	179	Med. Sand w/Clay Strks.	352	379	Med. Sand w/Clay Strks.
179	190	Sandy Clay w/Sand			
190	198	Med. Sand w/Clay Strks.			

7 CONTRACTOR'S OR LANDOWNER'S CERTIFICATION: This water well was (1) constructed, (2) reconstructed, or (3) plugged under my jurisdiction and was completed on (mo/day/year) 5-23-94 and this record is true to the best of my knowledge and belief. Kansas Water Well Contractor's License No. 554 This Water Well Record was completed on (mo/day/yr) 5-24-94
under the business name of Woofter Pump & Well, Inc. by (signature) Jay C. Woofter

INSTRUCTIONS: Use typewriter or ball point pen. *PLEASE PRESS FIRMLY* and *PRINT* clearly. Please fill in blanks, underline or circle the correct answers. Send top three copies to Kansas Department of Health and Environment, Bureau of Water, Topeka, Kansas 66620-0001. Telephone: 913-296-5545. Send one to WATER WELL OWNER and retain one for your records.