

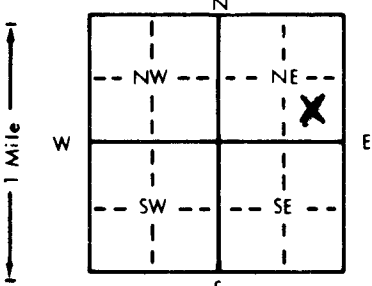
WATER WELL RECORD Form WWC-5 KSA 82a-1212

1 LOCATION OF WATER WELL:	Fraction	Section Number	Township Number	Range Number
County STANTON	N C 1/4 SE 1/4 NE 1/4	12	T 29 S	R 40 E/W

Distance and direction from nearest town or city street address of well if located within city?

4W BIG BOW 2 1/2 SOUTH, WEST INTO LOC.

2 WATER WELL OWNER: HUGOTON ENERGY	WESTWIND 1-12
RR#, St. Address, Box # : 229 E WILLIAM, STE. 500	Board of Agriculture, Division of Water Resources
City, State, ZIP Code : WICHITA, KS 67202	Application Number: 940203

3 LOCATE WELL'S LOCATION WITH AN "X" IN SECTION BOX:	4 DEPTH OF COMPLETED WELL: 360 ft. ELEVATION:
	Depth(s) Groundwater Encountered 1. 200 ft. 2. ft. 3. ft.
	WELL'S STATIC WATER LEVEL 200 ft. below land surface measured on mo/day/yr 6-13-94
	Pump test data: Well water was 215 ft. after 1 hours pumping 100 gpm
	Est. Yield 100 gpm: Well water was ft. after hours pumping gpm
	Bore Hole Diameter 11 in. to 360 ft. and in. to ft.
	WELL WATER TO BE USED AS:
	1 Domestic 3 Feedlot 6 Oil field water supply 8 Air conditioning 11 Injection well
	2 Irrigation 4 Industrial 7 Lawn and garden only 9 Dewatering 12 Other (Specify below)
	Was a chemical/bacteriological sample submitted to Department? Yes No X If yes, mo/day/yr sample was submitted
	Water Well Disinfected? Yes X No

5 TYPE OF BLANK CASING USED:	5 Wrought iron	8 Concrete tile	CASING JOINTS: Glued X Clamped
1 Steel	3 RMP (SR)	6 Asbestos-Cement	9 Other (specify below)
2 PVC	4 ABS	7 Fiberglass	10 Asbestos-cement
Blank casing diameter 6 in. to 360 ft. Dia			11 Other (specify)
Casing height above land surface 24 in., weight 2.902 lbs./ft. Wall thickness or gauge No. 316 SDR 21			12 None used (open hole)
TYPE OF SCREEN OR PERFORATION MATERIAL:			
1 Steel	3 Stainless steel	5 Fiberglass	8 RMP (SR)
2 Brass	4 Galvanized steel	6 Concrete tile	9 ABS
SCREEN OR PERFORATION OPENINGS ARE:			
1 Continuous slot	3 Mill slot	5 Gauzed wrapped	8 Saw cut
2 Louvered shutter	4 Key punched	6 Wire wrapped	9 Drilled holes
SCREEN-PERFORATED INTERVALS: From 260 ft. to 360 ft.			10 Other (specify)
GRAVEL PACK INTERVALS: From 160 ft. to 360 ft.			

6 GROUT MATERIAL:	1 Neat cement	2 Cement grout	3 Bentonite	4 Other HOLE PLUG
Grout Intervals: From 1 ft. to 20 ft.				
What is the nearest source of possible contamination:				
1 Septic tank	4 Lateral lines	7 Pit privy	10 Livestock pens	14 Abandoned water well
2 Sewer lines	5 Cess pool	8 Sewage lagoon	11 Fuel storage	15 Oil well/Gas well
3 Watertight sewer lines	6 Seepage pit	9 Feedyard	12 Fertilizer storage	16 Other (specify below)
Direction from well?			13 Insecticide storage	
			How many feet?	

FROM	TO	LITHOLOGIC LOG	FROM	TO	PLUGGING INTERVALS
0	2	TOP			
2	60	CLAY			
60	100	SANDY CLAY			
100	120	CLAY			
120	160	SANDY CLAY			
160	180	CLAY			
180	228	CLAY WITH SAND STREAKS			
228	354	SAND			
354	360	CLAY			

7 CONTRACTOR'S OR LANDOWNER'S CERTIFICATION: This water well was (1) constructed, (2) reconstructed, or (3) plugged under my jurisdiction and was completed on (mo/day/year) 6-13-94 and this record is true to the best of my knowledge and belief. Kansas Water Well Contractor's License No. KWWCL-430. This Water Well Record was completed on (mo/day/yr) 6-13-94 under the business name of HOWARD DRIG.CO.BOX 806 BEAVER,OK 73932 by (signature)
