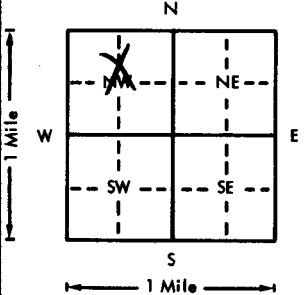


USE TYPEWRITER OR BALL
POINT PEN-PRESS FIRMLY,
PRINT CLEARLY.

WATER WELL RECORD
KSA 82a-1201-1215

Kansas Department of Health and
Environment-Division of Environment
(Water well Contractors)
Topeka, Kansas 66620

1. Location of well:		County STANTON	Fraction NW 1/4 SE 1/4 NW 1/4	Section number 13	Township number T 29 S	Range number R 40 W
2. Distance and direction from nearest town or city: 1 1/2 west 2 south 1 1/2 west 1 1/2 south of Big Bow		3. Owner of well: Basil Julian		R.R. or street: Johnson, Ms. 67855		
Street address or well location if in city:		City, state, zip code:				
4. Locate with "X" in section below:		Sketch map:		6. Bore hole dia. 26 in. Completion date 2-29-76 Well depth 460 ft.		
				7. Cable tool <input type="checkbox"/> Rotary <input type="checkbox"/> Driven <input type="checkbox"/> Dug <input type="checkbox"/> Hollow rod <input type="checkbox"/> Jetted <input type="checkbox"/> Bored <input checked="" type="checkbox"/> Reverse rotary		
5. Type and color of material		From	To	8. Use: Domestic <input type="checkbox"/> Public supply <input type="checkbox"/> Industry <input type="checkbox"/> <input checked="" type="checkbox"/> Irrigation <input type="checkbox"/> Air conditioning <input type="checkbox"/> Stock <input type="checkbox"/> Lawn <input type="checkbox"/> Oil field water <input type="checkbox"/> Other <input type="checkbox"/>		
				9. Casing: Material <u>steel</u> Height: Above or below Threaded <input type="checkbox"/> Welded <input checked="" type="checkbox"/> Surface <u>12</u> in. RMP <input type="checkbox"/> PVC <input type="checkbox"/> Weight <u>36.87</u> lbs./ft. Dia. <u>16</u> in. to <u>460</u> ft. depth Wall Thickness: inches or Dia. <u>16</u> in. to <u>460</u> ft. depth gage No. <u>16</u>		
				10. Screen: Manufacturer's name <u>Johnson Division</u> Type <u>Galv.</u> Dia. <u>16"</u> Slot/gauze <u>100</u> Length <u>20'</u> Set between <u>380</u> ft. and <u>400</u> ft. Perf. <u>240-380</u> and <u>400-460</u> Gravel pack <u>yes</u> Size range of material <u>3"</u> <u>Down</u>		
				11. Static water level: <u>167</u> ft. below land surface Date <u>1-30-76</u> mo./day/yr.		
				12. Pumping level below land surfaces: <u>178</u> ft. after <u>3</u> hrs. pumping <u>1250</u> p.m. ft. after hrs. pumping g.p.m. Estimated maximum yield <u>1250</u> g.p.m.		
				13. Water sample submitted: <u>X</u> mo./day/yr. Yes <u>X</u> No Date		
				14. Well head completion: <u>12</u> inches above grade Pitless adapter <u>yes</u>		
				15. Well grouted? <u>yes</u> With: Neat cement <input type="checkbox"/> Bentonite <input type="checkbox"/> <u>X</u> Concrete Depth: From <u>0</u> ft. to <u>10</u> ft.		
				16. Nearest source of possible contamination: <u>N/A</u> ft. Direction Type Well disinfected upon completion? <u>Yes</u> <u>X</u> No		
				17. Pump: Not installed Manufacturer's name <u>Peerless Pump FMC</u> Model number <u>11MC</u> HP <u>200</u> Volts Length of drop pipe <u>240</u> ft. capacity <u>1200</u> p.m. Type: <input type="checkbox"/> Submersible <input checked="" type="checkbox"/> Turbine <input type="checkbox"/> Jet <input type="checkbox"/> Reciprocating <input type="checkbox"/> Centrifugal <input type="checkbox"/> Other		
18. Elevation:		19. Remarks:		20. Water well contractor's certification: This well was drilled under my jurisdiction and this report is true to the best of my knowledge and belief. <u>Minter Wilson Drilling 208</u> Business name <u>Box A Garden City, Mo.</u> Address <u>9-1-76</u> Signed <u>[Signature]</u> Date <u>9-1-76</u> Authorized representative		
Topography: <input type="checkbox"/> Hill <input checked="" type="checkbox"/> Slope <input type="checkbox"/> Upland <input type="checkbox"/> Valley						

29 40 W 13 N
1/4 1/4 1/4
NUS
EW

Professional

MINTER-WILSON DRILLING CO.

INCORPORATED

Irrigation
and Domestic
Water Systems
Complete Installation
and Repairing

Phone 276-8269

P.O. Box 493

GARDEN CITY, KANSAS 67846

Basil Marhofer
Stanton County
12-23-75

Location: NW SW NW 13-29-40

From Basil Julian's res. - 1 mile West, $1\frac{1}{4}$ mile
South

Test # 1

0	1	Top Soil
1	56	Brown Clay
56	65	Fine to Med. Sand & Gravel, 20% Clay (Loose)
65	82	Brown Clay & White Rock (Tight)
82	103	Fine to Med. Sand & Gravel (Hard Streaks)
103	110	Fine to Med. Sand & Gravel, 1% Clay (Loose)
110	142	Fine to Med. Sand & Gravel (Loose)
142	155	Fine to Med. Sand & Gravel, 10% Clay (Loose)
155	170	Fine to Med. Sand & Gravel (Loose)
170	185	Brown Clay
185	193	Fine to Med. Sand & Gravel (Loose)
193	200	Brown Clay
200	224	Fine to Med. Sand & Gravel, 10% Clay (Loose)
224	294	Fine to Med. Sand & Gravel (Loose)
294	305	Brown Sandy Clay & Brown Clay
305	402	Fine to Med. Sand & Gravel (Loose)
402	410	Brown Clay
410	425	Fine to Med. Sand & Gravel, 30% Clay
425	460	Fine to Med. Sand & Gravel, 10% Clay (Loose)
460	470	Brown, Gray & Red Clay with Brown Rock (Hard)