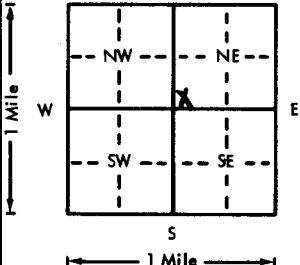


USE TYPEWRITER OR BALL
POINT PEN-PRESS FIRMLY,
PRINT CLEARLY.

WATER WELL RECORD
KSA 82a-1201-1215

Kansas Department of Health and
Environment-Division of Environment
(Water well Contractors)
Topeka, Kansas 66620

1. Location of well:		County <u>Stanton</u>	Fraction <u>SW 1/4 SW 1/4 NE 1/4</u>	Section number <u>16</u>	Township number <u>T 29 S</u>	Range number <u>R 40 E/W</u>
2. Distance and direction from nearest town or city: <u>2 1/2 miles south of Johnson, Ks.</u>			3. Owner of well: <u>Robert Martin</u> R.R. or street: <u>Johnson, Kansas</u> City, state, zip code:			
4. Locate with "X" in section below: N  S 1 Mile			Sketch map:			
5. Type and color of material			From	To	6. Bore hole dia. <u>27</u> in. Completion date <u>9/2/76</u> Well depth <u>518</u> ft.	
Surface			0	2	7. <input type="checkbox"/> Cable tool <input checked="" type="checkbox"/> Rotary <input type="checkbox"/> Driven <input type="checkbox"/> Dug <input type="checkbox"/> Hollow rod <input type="checkbox"/> Jetted <input type="checkbox"/> Bored <input type="checkbox"/> Reverse rotary	
Sandy clay			2	56	8. Use: <input type="checkbox"/> Domestic <input type="checkbox"/> Public supply <input type="checkbox"/> Industry <input checked="" type="checkbox"/> Irrigation <input type="checkbox"/> Air conditioning <input type="checkbox"/> Stock <input type="checkbox"/> Lawn <input type="checkbox"/> Oil field water <input type="checkbox"/> Other	
Medium to coarse sand			56	80	9. Casing: Material <u>Steel</u> Height: <u>Above</u> or below Threaded <input type="checkbox"/> Welded <input checked="" type="checkbox"/> Surface <u>14</u> in. RMP <input type="checkbox"/> PVC <input type="checkbox"/> Weight <u>36.8</u> lbs./ft. Dia. <u>16</u> in. <u>230.5</u> ft. depth Wall Thickness: inches or Dia. <u>16</u> in. to <u>230.5</u> ft. depth gauge No. <u>219</u>	
Sandy clay w/fine to medium sand strips			80	120	10. Screen: Manufacturer's name <u>Lakewood</u> <u>Pipe of Texas</u> Type <u>steel</u> Dia. <u>16</u> in. Slot/gauze <u>3/16</u> Length <u>287.7</u> ft. Set between <u>230.5</u> ft. and <u>287.7</u> ft. Gravel pack? <input checked="" type="checkbox"/> Size range of material <u>1/4 X 5/8</u>	
Medium to coarse sand			120	172	11. Static water level: <u>176</u> ft. below land surface Date <u>5/20/76</u> mo./day/yr.	
Sandy clay w/medium sand strips			172	187	12. Pumping level below land surfaces: <u>205</u> ft. after <u>12</u> hrs. pumping <u>1600</u> g.p.m. ____ ft. after ____ hrs. pumping ____ g.p.m. Estimated maximum yield <u>2000</u> g.p.m.	
Medium to coarse sand			187	202	13. Water sample submitted: <u>X</u> mo./day/yr. Yes <input checked="" type="checkbox"/> No <input type="checkbox"/> Date	
Sandy clay w/medium sand strips 1-1-2			202	209	14. Well head completion: <u>NA</u> Pitless adapter <u>NA</u> inches above grade	
Medium to coarse sand			209	367	15. Well grouted? <input checked="" type="checkbox"/> With: <input checked="" type="checkbox"/> Neat cement <input type="checkbox"/> Bentonite <input type="checkbox"/> Concrete Depth: From <u>0</u> ft. to <u>10</u> ft.	
Sandy clay w/medium sand strips 2-1			367	374	16. Nearest source of possible contamination: <u>NA</u> ft. ____ Direction ____ Type ____ Well disinfected upon completion? <input type="checkbox"/> Yes <input checked="" type="checkbox"/> No	
Medium to coarse sand			374	393	17. Pump: <input checked="" type="checkbox"/> Not installed Manufacturer's name ____ Model number ____ HP ____ Volts ____ Length of drop pipe ____ ft. capacity ____ g.p.m. Type: <input type="checkbox"/> Submersible <input type="checkbox"/> Turbine <input type="checkbox"/> Jet <input type="checkbox"/> Reciprocating <input type="checkbox"/> Centrifugal <input type="checkbox"/> Other	
Sandy clay w/fine to medium sand strips 2-1-1-4			393	400	20. Water well contractor's certification: This well was drilled under my jurisdiction and this report is true to the best of my knowledge and belief. <u>Houck Bros. Drlg. Co.</u> <u>164</u> Business name <u>Box 487, Ulysses, Ks.</u> Address Signed <u>Malvin M. Beare</u> Date <u>10/15/76</u> Authorized representative	
Fine to medium sand w/clay breakers			400	490		
Medium to coarse sand			490	512		
Sandy clay, yellow chalk and sandrock			512	518		
(Use a second sheet if needed)						
18. Elevation:		19. Remarks:				
Topography: <input type="checkbox"/> Hill <input checked="" type="checkbox"/> Slope <input type="checkbox"/> Upland <input type="checkbox"/> Valley						