USE TYPEWRITER OR BALL POINT PEN-PRESS FIRMLY, PRINT CLEARLY.

T R EW sec 1/4 1/4 1/4 No.

WATER WELL RECORD
KSA 82a-1201-1215

Kansas State Dept. Of Health
(Water Well Contractors)
Forbes-Bldg. 740
Topeka, Kansas 66620

1 Location of well:	County	Township name	Fraction	Section number	Town number	Range number
	Stanton	Johnson	NE¼ NW¼ NW¼	26	29 S	40 W

Distance and direction from nearest town or city: 5 Mile South + 5 ¼ Mi East

Street address of well location if in city:

3 Owner of well: Jerry Jones.

Address: Johnson Kansas.

Locate with "X" in section below:

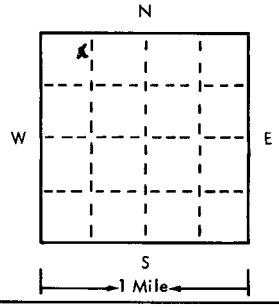

Sketch map:

2 Type and color of material	From	To
Surface	0	5
Sand Fine	5	20
Clay w/ Stripy Sand	20	120
Sand fine - medium	120	166
Clay	166	176
Sand medium	176	257
Clay w/ fine Sand.	257	300'
(use a second sheet if needed)		

4 Well depth: 300' ft. Date of completion 6-20 75
Well diameter 10" in.

5 ☐ Cable tool ☑ Rotary ☐ Driven ☐ Dug
☐ Hollow rod ☐ Jetted ☐ Bored ☐ Reverse rotary

6 Use: ☑ Domestic ☐ Public supply ☐ Industry
☐ Irrigation ☐ Air conditioning ☐ Commercial
☐ Test well ☐ _____

7 Casing: Material Styrene Height: ~~above~~/below
Threaded ☐ Welded ☑ Surface 3' in.
Diam. Weight 320 lbs./ft. 1
5 in. to 300 ft. depth Drive shoe? ☐ Yes ☑ No
___ in. to ___ ft. depth

8 Screen:
Manufacturer Sunflower
Type Styrene Dia. 5
Slot/~~gauge~~ _____ Length 40'
Set between 260 ft. and 300 ft.
Fittings:
Gravel pack ☑ Yes ☐ No Size range of material #1

9 Static water level:
125' ft. below land surface Date 9-3-75

10 Pumping level below land surfaces:
180' ft. after 24 hrs. pumping 10 g.p.m.
___ ft. after ___ hrs. pumping ___ g.p.m.
Estimated maximum yield Unknown g.p.m.

11 Water sample submitted:
☐ Yes ☑ No Date _____

12 Well head completion:
☑ Pitless adapter unit ☐ Inches above grade

13 Well grouted? ☑ Yes ☐ No
☑ Neat cement ☐ Bentonite ☐ _____
Depth: From 3 ft. to 15 ft.

14 Nearest source of possible contamination:
ft. 100' Direction ~~South~~ East Type Sewer
Well disinfected upon completion? ☑ Yes ☐ No

15 Pump: ☐ Not installed
Manufacturer's name Jacuzzi Bro.
Model number 1548 HP 1 Volts 220
Length of drop pipe 190' ft. capacity 10 g.m.p.
Type:
☑ Submersible ☐ Turbine
☐ Jet ☐ Reciprocating
☐ Certrifugal ☐ Other

16 Remarks: elevation

Topography:
☐ Hill
☑ Slope
☐ Upland
☐ Valley

17 Water well contractor's certification:
This well was drilled under my jurisdiction and this report is true to the best of my knowledge and belief.
Jim Smith Pump Serv. 160
Business name License No.
Address Box 307
Signed Jim Smith Date 8-26-75
Authorized representative

Forward the white, blue and pink copies to the Kansas State Dept. Of Health.

Form WWC-5