


1 LOCATION OF WATER WELL: County: STANTON	Fraction NW 1/4 NE 1/4 NE 1/4	Section Number 15	Township Number T 29 S	Range Number R 41W E/W
---	---	-----------------------------	----------------------------------	----------------------------------

Distance and direction from nearest town or city street address of well if located within city?

2 MILES SOUTHWEST FROM JOHNSON, KS

2 WATER WELL OWNER: CHEYENNE DRILLING RR#, St. Address, Box #: P.O. BOX 916 City, State, ZIP Code: GARDEN CITY, KS 67846	# 15-1 KENDRICK Board of Agriculture, Division of Water Resources Application Number: 930325
---	--

3 LOCATE WELL'S LOCATION WITH AN "X" IN SECTION BOX:

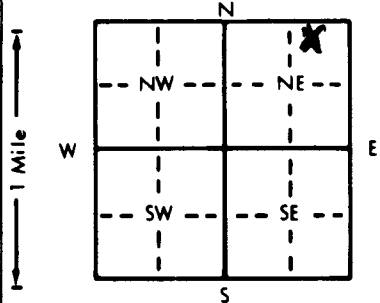

4 DEPTH OF COMPLETED WELL: **410** ft. ELEVATION: _____

Depth(s) Groundwater Encountered 1. _____ ft. 2. _____ ft. 3. _____ ft.

WELL'S STATIC WATER LEVEL: **250** ft. below land surface measured on **4-6-95**

Pump test data: Well water was _____ ft. after _____ hours pumping _____ gpm

Est. Yield _____ gpm: Well water was _____ ft. after _____ hours pumping _____ gpm

Bore Hole Diameter _____ in. to _____ ft., and _____ in. to _____ ft.

WELL WATER USED AS:

<input checked="" type="checkbox"/> 5 Public water supply	<input type="checkbox"/> 8 Air conditioning	<input type="checkbox"/> 11 Injection well
<input type="checkbox"/> 1 Domestic WAS	<input checked="" type="checkbox"/> 3 Feedlot	<input type="checkbox"/> 9 Dewatering
<input type="checkbox"/> 2 Irrigation	<input type="checkbox"/> 4 Industrial	<input type="checkbox"/> 7 Lawn and garden only
<input type="checkbox"/> 3 Feedlot	<input type="checkbox"/> 10 Monitoring well	<input type="checkbox"/> 12 Other (Specify below)

Was a chemical/bacteriological sample submitted to Department? Yes _____ No _____; If yes, mo/day/yr sample was submitted _____

Water Well Disinfected? Yes _____ No _____

5 TYPE OF BLANK CASING USED:

<input checked="" type="checkbox"/> 1 Steel	<input type="checkbox"/> 3 RMP (SR)	<input type="checkbox"/> 6 Asbestos-Cement	<input type="checkbox"/> 9 Other (specify below)
<input checked="" type="checkbox"/> 2 PVC	<input type="checkbox"/> 4 ABS	<input type="checkbox"/> 7 Fiberglass	

CASING JOINTS: Glued _____ Clamped _____
Welded _____
Threaded _____

Blank casing diameter **5** in. to **410** ft., Dia _____ in. to _____ ft., Dia _____ in. to _____ ft.

Casing height above land surface **5' BELOW** in., weight _____ lbs./ft. Wall thickness or gauge No. _____

TYPE OF SCREEN OR PERFORATION MATERIAL:

<input type="checkbox"/> 1 Steel	<input type="checkbox"/> 3 Stainless steel	<input type="checkbox"/> 5 Fiberglass	<input type="checkbox"/> 8 RMP (SR)	<input type="checkbox"/> 11 Other (specify)
<input type="checkbox"/> 2 Brass	<input type="checkbox"/> 4 Galvanized steel	<input type="checkbox"/> 6 Concrete tile	<input type="checkbox"/> 9 ABS	<input type="checkbox"/> 12 None used (open hole)

SCREEN OR PERFORATION OPENINGS ARE:

<input type="checkbox"/> 1 Continuous slot	<input type="checkbox"/> 3 Mill slot	<input type="checkbox"/> 5 Gauzed wrapped	<input type="checkbox"/> 8 Saw cut	<input type="checkbox"/> 11 None (open hole)
<input type="checkbox"/> 2 Louvered shutter	<input type="checkbox"/> 4 Key punched	<input type="checkbox"/> 6 Wire wrapped	<input type="checkbox"/> 9 Drilled holes	
<input type="checkbox"/> 7 Torch cut	<input type="checkbox"/> 10 Other (specify)			

SCREEN-PERFORATED INTERVALS: From _____ ft. to _____ ft., From _____ ft. to _____ ft.

GRAVEL PACK INTERVALS: From _____ ft. to _____ ft., From _____ ft. to _____ ft.

6 GROUT MATERIAL: 1 Neat cement 2 Cement grout 3 Bentonite 4 Other _____

Grout Intervals: From **8** ft. to **5** ft., From _____ ft. to _____ ft., From _____ ft. to _____ ft.

What is the nearest source of possible contamination:

<input type="checkbox"/> 1 Septic tank	<input type="checkbox"/> 4 Lateral lines	<input type="checkbox"/> 7 Pit privy	<input type="checkbox"/> 10 Livestock pens	<input type="checkbox"/> 14 Abandoned water well
<input type="checkbox"/> 2 Sewer lines	<input type="checkbox"/> 5 Cess pool	<input type="checkbox"/> 8 Sewage lagoon	<input type="checkbox"/> 11 Fuel storage	<input checked="" type="checkbox"/> 15 Oil well/Gas well
<input type="checkbox"/> 3 Watertight sewer lines	<input type="checkbox"/> 6 Seepage pit	<input type="checkbox"/> 9 Feedyard	<input type="checkbox"/> 12 Fertilizer storage	<input type="checkbox"/> 16 Other (specify below)
			<input type="checkbox"/> 13 Insecticide storage	

Direction from well? **Southeast** How many feet? **150**

FROM	TO	LITHOLOGIC LOG	FROM	TO	PLUGGING INTERVALS
			410	235	CHLORINATED GRAVEL
			235	220	HOLE PLUG
			220	5	CEMENT GROUT
			5	0	BACKFILL

7 CONTRACTOR'S OR LANDOWNER'S CERTIFICATION: This water well was (1) constructed, (2) reconstructed, or (3) plugged under my jurisdiction and was completed on (mo/day/year) **4-6-95** and this record is true to the best of my knowledge and belief. Kansas Water Well Contractor's License No. **KWACL-430**. This Water Well Record was completed on (mo/day/yr) **4-6-95** under the business name of **HOWARD DRIG, CO. BOX 806 BEAVER, OK 73932** by (signature) *Howard Drig*

INSTRUCTIONS: Use typewriter or ball point pen. PLEASE PRESS FIRMLY and PRINT clearly. Please fill in blanks, underline or circle the correct answers. Send top three copies to Kansas Department of Health and Environment, Bureau of Water, Topeka, Kansas 66620-0001. Telephone: 913-296-5545. Send one to WATER WELL OWNER and retain one for your records.

#20790