

1 LOCATION OF WATER WELL:	Fraction	Section Number	Township Number	Range Number
County: <b>STANTON</b>	<b>W2 1/4 SE 1/4 NW 1/4</b>	<b>10</b>	<b>T 29 S</b>	<b>R 41W EW</b>

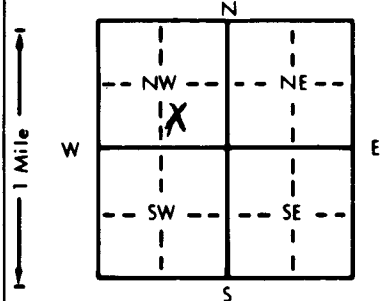
Distance and direction from nearest town or city street address of well if located within city?

2 1/2 MILES ~~Southwest~~ **Southwest** **Stanton, KS**2 WATER WELL OWNER: **H & L OPERATING**RR#, St. Address, Box #: **BOX 7506**City, State, ZIP Code: **AMARILLO, TX 79114**# 1-10 **POWELL**

Board of Agriculture, Division of Water Resources

Application Number: **950292**

3 LOCATE WELL'S LOCATION WITH AN "X" IN SECTION BOX:

4 DEPTH OF COMPLETED WELL: **460** ft. ELEVATION:Depth(s) Groundwater Encountered 1. **320** ft. 2. ft. 3. ft.WELL'S STATIC WATER LEVEL **320** ft. below land surface measured on mo/day/yr **09-04-95**Pump test data: Well water was **335** ft. after **1** hours pumping **90** gpmEst. Yield **90** gpm: Well water was ft. after hours pumping gpmBore Hole Diameter **11** in. to **460** ft., and in. to ft.

WELL WATER TO BE USED AS: 5 Public water supply 8 Air conditioning 11 Injection well

1 Domestic 3 Feedlot **6** Oil field water supply 9 Dewatering 12 Other (Specify below)2 Irrigation 4 Industrial **7** Lawn and garden only 10 Monitoring wellWas a chemical/bacteriological sample submitted to Department? Yes.....No.....**X**..... If yes, mo/day/yr sample was submittedWater Well Disinfected? Yes **X** No

5 TYPE OF BLANK CASING USED:

1 Steel 3 RMP (SR)

**2** PVC 4 ABS

5 Wrought iron

6 Asbestos-Cement

7 Fiberglass

8 Concrete tile

9 Other (specify below)

CASING JOINTS: Glued **X** Clamped

Welded

Threaded

Blank casing diameter **6** in. to **460** ft., Dia in. to ft., Dia in. to ft.Casing height above land surface **24** in., weight **2,902** lbs./ft. Wall thickness or gauge No. **280 SDR 21**

TYPE OF SCREEN OR PERFORATION MATERIAL:

1 Steel 3 Stainless steel

2 Brass 4 Galvanized steel

5 Fiberglass

6 Concrete tile

**7** PVC

8 RMP (SR)

9 ABS

10 Asbestos-cement

11 Other (specify)

12 None used (open hole)

SCREEN OR PERFORATION OPENINGS ARE:

1 Continuous slot

3 Mill slot

5 Gauzed wrapped

6 Wire wrapped

**8** Saw cut

9 Drilled holes

11 None (open hole)

2 Louvered shutter

4 Key punched

7 Torch cut

10 Other (specify)

SCREEN-PERFORATED INTERVALS: From **460** ft. to **360** ft., From ft. to ft.

From ft. to ft., From ft. to ft.

GRAVEL PACK INTERVALS: From **260** ft. to **360** ft., From ft. to ft.

From ft. to ft., From ft. to ft.

6 GROUT MATERIAL:

**1** Heat cement

2 Cement grout

3 Bentonite

**4** Other **HOLE PLUG**Grout Intervals: From **0** ft. to **16** ft., From ft. to ft., From ft. to ft.

What is the nearest source of possible contamination:

1 Septic tank

4 Lateral lines

7 Pit privy

10 Livestock pens

14 Abandoned water well

2 Sewer lines

5 Cess pool

8 Sewage lagoon

11 Fuel storage

**15** Oil well/Gas well

3 Watertight sewer lines 6 Seepage pit

9 Feedyard

12 Fertilizer storage

13 Insecticide storage

16 Other (specify below)

Direction from well? **Southwest**How many feet? **125**

FROM	TO	LITHOLOGIC LOG	FROM	TO	PLUGGING INTERVALS
0	2	TOP CLAY	243	260	SAND
2	21	CLAY	260	270	SAND & SANDY CLAY
21	52	SANDY CLAY & SAND	270	280	SAND
52	90	SANDY CLAY & CLAY	280	290	SAND & SANDY CLAY
90	118	COARSE SAND	290	300	COARSE SAND
118	126	SANDY CLAY	300	321	SANDY CLAY & CLAY
126	135	SAND & SANDY CLAY	321	340	SAND & SANDY CLAY
135	146	SAND	340	360	CLAY & SANDY CLAY
146	152	CLAY	360	365	SANDY CLAY
152	165	SAND	365	372	COARSE SAND
165	176	COARSE SAND W/CLAY STREAKS	372	375	CLAY
176	184	CLAY	375	382	COARSE SAND
184	202	SANDY CLAY & CLAY	382	406	CLAY & SANDY CLAY STREAKS
202	220	COARSE SAND W/CLAY STREAKS	406	425	COARSE SAND
220	243	SAND & SANDY CLAY	425	435	SANDY CLAY

7 CONTRACTOR'S OR LANDOWNER'S CERTIFICATION: This water well was **(1)** constructed, (2) reconstructed, or (3) plugged under my jurisdiction and was completed on (mo/day/year) **09-04-95** and this record is true to the best of my knowledge and belief. KansasWater Well Contractor's License No. **KWCL-430** This Water Well Record was completed on (mo/day/yr) **09-04-95**under the business name of **HOWARD DRUG CO. BOX 806 BEAVER, OK 73932** by (signature) *[Signature]*