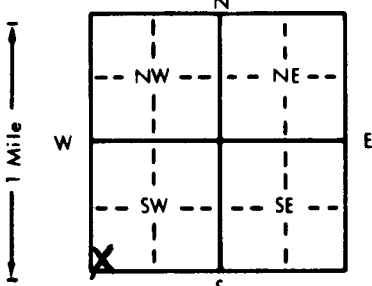


|   |   |                             |                                  |  |
|---|---|-----------------------------|----------------------------------|--|
| 1 LOCATION OF WATER WELL:<br>County: <b>Stanton</b> | Fraction<br><b>SW</b> ¼ <b>SW</b> ¼ <b>SW</b> ¼ | Section Number<br><b>11</b> | Township Number<br>T <b>29</b> S | Range Number<br>R <b>41</b> E <b>W</b> |
|---|---|-----------------------------|----------------------------------|--|

Distance and direction from nearest town or city street address of well if located within city?

**Johnson City: 2S., on 27, 1W., & NE into**


|  |  |
|--|--|
| 2 WATER WELL OWNER: <b>JM Huber</b><br>RR#, St. Address, Box # : <b>1900 W Loop Ste 1600</b><br>City, State, ZIP Code : <b>Houston, TX 77027</b> | #11-3 <b>Ruby Arnold</b><br>Board of Agriculture, Division of Water Resources<br>Application Number: <b>960320</b> |
|--|--|

|  |   |
|--|---|
| 3 LOCATE WELL'S LOCATION WITH AN "X" IN SECTION BOX:<br> | 4 DEPTH OF COMPLETED WELL: <b>440</b> ft. ELEVATION: ..... ft.<br>Depth(s) Groundwater Encountered 1. <b>260</b> ft. 2. .... ft. 3. .... ft.<br>WELL'S STATIC WATER LEVEL <b>260</b> ft. below land surface measured on mo/day/yr <b>9-17-96</b><br>Pump test data: Well water was <b>357</b> ft. after <b>1</b> hours pumping <b>100</b> gpm<br>Est. Yield <b>100</b> gpm: Well water was ..... ft. after ..... hours pumping ..... gpm<br>Bore Hole Diameter <b>11</b> in. to <b>440</b> ft., and ..... in. to ..... ft.<br>WELL WATER TO BE USED AS: 5 Public water supply 8 Air conditioning 11 Injection well<br>1 Domestic 3 Feedlot <b>6</b> Oil field water supply 9 Dewatering 12 Other (Specify below)<br>2 Irrigation 4 Industrial 7 Lawn and garden only 10 Monitoring well .....<br>Was a chemical/bacteriological sample submitted to Department? Yes.....No... <b>X</b> .....; If yes, mo/day/yr sample was submitted<br>Water Well Disinfected? Yes <b>X</b> No |
|--|---|

|   |  |
|---|--|
| 5 TYPE OF BLANK CASING USED:<br>1 Steel<br><b>2</b> PVC<br>3 RMP (SR)<br>4 ABS<br>Blank casing diameter <b>6</b> in. to <b>440</b> ft., Dia ..... in. to ..... ft.<br>Casing height above land surface <b>24</b> in., weight <b>2.902</b> lbs./ft. Wall thickness or gauge No. <b>.281 SDR 21</b> | 5 Wrought iron<br>6 Asbestos-Cement<br>7 Fiberglass<br>8 Concrete tile<br>9 Other (specify below)<br>CASING JOINTS: Glued <b>X</b> Clamped .....<br>Welded .....<br>Threaded .....   |
| TYPE OF SCREEN OR PERFORATION MATERIAL:<br>1 Steel<br>2 Brass<br>3 Stainless steel<br>4 Galvanized steel<br>5 Fiberglass<br>6 Concrete tile<br>7 PVC<br>8 RMP (SR)<br>9 ABS<br>10 Asbestos-cement<br>11 Other (specify) .....<br>12 None used (open hole)   | SCREEN OR PERFORATION OPENINGS ARE:<br>1 Continuous slot<br>2 Louvered shutter<br>3 Mill slot<br>4 Key punched<br>5 Gauzed wrapped<br>6 Wire wrapped<br>7 Torch cut<br>8 Saw cut<br>9 Drilled holes<br>10 Other (specify) .....<br>11 None (open hole) |
| SCREEN-PERFORATED INTERVALS: From <b>340</b> ft. to <b>440</b> ft., From ..... ft. to ..... ft.<br>From ..... ft. to ..... ft., From ..... ft. to ..... ft.   | GRAVEL PACK INTERVALS: From <b>240</b> ft. to <b>440</b> ft., From ..... ft. to ..... ft.<br>From ..... ft. to ..... ft., From ..... ft. to ..... ft.  |

|  |   |
|--|---|
| 6 GROUT MATERIAL: <b>1</b> Neat cement<br>2 Cement grout<br>3 Bentonite<br>4 Other <b>Hole Plug</b><br>Grout Intervals: From <b>0</b> ft. to <b>16</b> ft., From ..... ft. to ..... ft., From ..... ft. to ..... ft. | What is the nearest source of possible contamination:<br>1 Septic tank<br>2 Sewer lines<br>3 Watertight sewer lines<br>4 Lateral lines<br>5 Cess pool<br>6 Seepage pit<br>7 Pit privy<br>8 Sewage lagoon<br>9 Feedyard<br>10 Livestock pens<br>11 Fuel storage<br>12 Fertilizer storage<br>13 Insecticide storage<br>14 Abandoned water well<br><b>15</b> Oil well/Gas well<br>16 Other (specify below)<br>Direction from well? <b>South</b><br>How many feet? <b>200</b> |
|--|---|

| FROM | TO  | LITHOLOGIC LOG      | FROM | TO  | PLUGGING INTERVALS |
|------|-----|---------------------|------|-----|--------------------|
| 0    | 36  | Sandy Clay          | 432  | 440 | Sandy Clay / Clay  |
| 36   | 41  | Clay                |      |     |                    |
| 41   | 86  | Sandy Clay / Clay   |      |     |                    |
| 86   | 174 | Sand                |      |     |                    |
| 174  | 184 | Clay                |      |     |                    |
| 184  | 195 | Sand                |      |     |                    |
| 195  | 199 | Clay                |      |     |                    |
| 199  | 204 | Sand                |      |     |                    |
| 204  | 215 | Sandy Clay / Clay   |      |     |                    |
| 215  | 300 | Sand / Clay Streaks |      |     |                    |
| 300  | 340 | Sandy Clay / Clay   |      |     |                    |
| 340  | 370 | Sand / Clay         |      |     |                    |
| 370  | 390 | Sand                |      |     |                    |
| 390  | 410 | Sandy Clay / Sand   |      |     |                    |
| 410  | 432 | Sand                |      |     |                    |

|  |
|--|
| 7 CONTRACTOR'S OR LANDOWNER'S CERTIFICATION: This water well was <b>(1)</b> constructed, (2) reconstructed, or (3) plugged under my jurisdiction and was completed on (mo/day/year) <b>9-17-96</b> and this record is true to the best of my knowledge and belief. Kansas Water Well Contractor's License No. <b>KWCL - 430</b> This Water Well Record was completed on (mo/day/yr) <b>9-17-96</b> under the business name of <b>Howard Drlg. Box 806, Beaver, Ok 73932</b> by signature  |
|--|