


**WATER WELL RECORD Form WWC-5 KSA 82a-1212**

<b>1 LOCATION OF WATER WELL:</b> County: <u>Stanton</u>	<b>Fraction</b> NE ¼ NE ¼ NE ¼	<b>Section Number</b> <u>16</u>	<b>Township Number</b> T 29S S	<b>Range Number</b> R 41W E <u>(W)</u>
--	-----------------------------------	------------------------------------	-----------------------------------	---

Distance and direction from nearest town or city street address of well if located within city?  
3 SW of Johnson, KS

<b>2 WATER WELL OWNER:</b> <u>Murfin Drilling</u>	# <u>16-1 Fretz</u>
RR#, St. Address, Box # : <u>250 N Water, Suite #100</u>	Board of Agriculture, Division of Water Resources
City, State, ZIP Code : <u>Wichita, KS 67202</u>	Application Number: <u>920046</u>

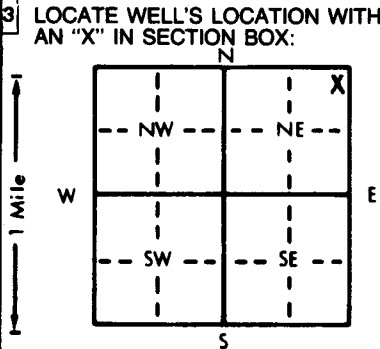

**4 DEPTH OF COMPLETED WELL:** 400 ft. ELEVATION: \_\_\_\_\_ ft.

Depth(s) Groundwater Encountered 1. 230 ft. 2. \_\_\_\_\_ ft. 3. \_\_\_\_\_ ft.

WELL'S STATIC WATER LEVEL 230 ft. below land surface measured on mo/day/yr 2/04/92

Pump test data: Well water was 363 ft. after 1 hours pumping 75 gpm

Est. Yield 75 gpm: Well water was \_\_\_\_\_ ft. after \_\_\_\_\_ hours pumping \_\_\_\_\_ gpm

Bore Hole Diameter: 1.1 in. to 400 ft., and \_\_\_\_\_ in. to \_\_\_\_\_ ft.

WELL WATER TO BE USED AS:

5 Public water supply	8 Air conditioning	11 Injection well
1 Domestic	3 Feedlot	<input checked="" type="radio"/> 6 Oil field water supply
2 Irrigation	4 Industrial	9 Dewatering
	7 Lawn and garden only	10 Monitoring well
		12 Other (Specify below)

Was a chemical/bacteriological sample submitted to Department? Yes \_\_\_\_\_ No  X \_\_\_\_\_ If yes, mo/day/yr sample was submitted \_\_\_\_\_

Water Well Disinfected? Yes  X No \_\_\_\_\_

**5 TYPE OF BLANK CASING USED:**

1 Steel	3 RMP (SR)	5 Wrought iron	8 Concrete tile	CASING JOINTS: Glued <input checked="" type="checkbox"/> X Clamped _____
<input checked="" type="radio"/> 2 PVC	4 ABS	6 Asbestos-Cement	9 Other (specify below)	Welded _____
		7 Fiberglass		Threaded _____

Blank casing diameter 6 in. to 400 ft., Dia \_\_\_\_\_ in. to \_\_\_\_\_ ft., Dia \_\_\_\_\_ in. to \_\_\_\_\_ ft.

Casing height above land surface 24 in., weight \_\_\_\_\_ lbs./ft. Wall thickness or gauge No. .032

**TYPE OF SCREEN OR PERFORATION MATERIAL:**

1 Steel	3 Stainless steel	5 Fiberglass	<input checked="" type="radio"/> 7 PVC	10 Asbestos-cement
2 Brass	4 Galvanized steel	6 Concrete tile	8 RMP (SR)	11 Other (specify) _____
			9 ABS	12 None used (open hole)

SCREEN OR PERFORATION OPENINGS ARE:

1 Continuous slot	3 Mill slot	5 Gauzed wrapped	<input checked="" type="radio"/> 8 Saw cut	11 None (open hole)
2 Louvered shutter	4 Key punched	6 Wire wrapped	9 Drilled holes	
		7 Torch cut	10 Other (specify) _____	

SCREEN-PERFORATED INTERVALS: From 240 ft. to 280 ft., From 360 ft. to 400 ft.

GRAVEL PACK INTERVALS: From 200 ft. to 400 ft., From \_\_\_\_\_ ft. to \_\_\_\_\_ ft.

**6 GROUT MATERIAL:**  1 Neat cement 2 Cement grout 3 Bentonite  4 Other Hole Plug

Grout Intervals: From 1 ft. to 20 ft., From \_\_\_\_\_ ft. to \_\_\_\_\_ ft., From \_\_\_\_\_ ft. to \_\_\_\_\_ ft.

What is the nearest source of possible contamination:

1 Septic tank	4 Lateral lines	7 Pit privy	10 Livestock pens	14 Abandoned water well
2 Sewer lines	5 Cess pool	8 Sewage lagoon	11 Fuel storage	<input checked="" type="radio"/> 15 Oil well/Gas well
3 Watertight sewer lines	6 Seepage pit	9 Feedyard	12 Fertilizer storage	16 Other (specify below)
			13 Insecticide storage	

Direction from well? Northeast How many feet? 180

FROM	TO	LITHOLOGIC LOG	FROM	TO	PLUGGING INTERVALS
0	1	Surface Soil			
1	65	Clay			
65	71	Sandy Clay			
71	78	Sand			
78	104	Sandy Clay			
104	142	Sand and Streaks of Clay			
142	164	Clay			
164	204	Sandy Clay			
204	270	Sand and Gravel			
270	362	Clay			
362	390	Sand			
390	400	Blue Clay			

**7 CONTRACTOR'S OR LANDOWNER'S CERTIFICATION:** This water well was  (1) constructed, (2) reconstructed, or (3) plugged under my jurisdiction and was completed on (mo/day/year) 2/13/92 and this record is true to the best of my knowledge and belief. Kansas Water Well Contractor's License No. KWWCL-430 This Water Well Record was completed on (mo/day/yr) 2/13/92 under the business name of Howard Drlg. Co. Box 806 Beaver, OK 73932 by (signature) *[Signature]*

INSTRUCTIONS: Use typewriter or ball point pen. PLEASE PRESS FIRMLY and PRINT clearly. Please fill in blanks, underline or circle the correct answers. Send top three copies to Kansas Department of Health and Environment, Bureau of Water, Topeka, Kansas 66620-0001. Telephone: 913-296-5545. Send one to WATER WELL OWNER and retain one for your records.