USE TYPEWRITER OR BALL POINT PEN-PRESS FIRMLY, PRINT CLEARLY.

WATER WELL RECORD
KSA 82a-1201-1215

Kansas Department of Health and Environment-Division of Environment
(Water well Contractors)
Topeka, Kansas 66620

1. Location of well:	County	Fraction	Section number	Township number	Range number
	Stanton	SE 1/4 SW 1/4 SE 1/4	20	T 29 S	R 41 E (W)

2. Distance and direction from nearest town or city: 4 miles west, 2½ south 1 East from port of entry at Johnson, Ks.
Street address of well location if in city:

3. Owner of well: William F. Haney
R.R. or street:
City, state, zip code: Johnson, Ks. 67855

4. Locate with "X" in section below: Sketch map:

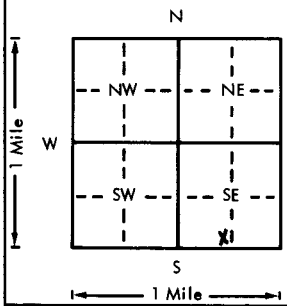

5. Type and color of material	From	To
Surface	0	2
Fine to medium sand w/clay breakers	2	123
Medium to coarse sand w/sandrock & clay breakers	123	159
Gray clay, blue shale & Dakota Tight	159	180
Blue shale	180	247
Blue shale & Dakota 5%	247	308
False red bed, brown shale, Dakota and Cheyene (hard) 25%	308	381

(Use a second sheet if needed)

6. Bore hole dia. 9¼ in. Completion date 7/29/77
Well depth 381 ft.

7. __ Cable tool X Rotary __ Driven __ Dug
__ Hollow rod __ Jetted __ Bored __ Reverse rotary

8. Use: X Domestic __ Public supply __ Industry
__ Irrigation __ Air conditioning __ Stock
__ Lawn __ Oil field water __ Other

9. Casing: Material styrene Weight: (Above) or below
Threaded __ Welded glued Surface 24 in.
RMP __ PVC __ Weight __ lbs./ft.
Dia. 5 in. to 301 ft. depth Wall Thickness: inches or
Dia. __ in. to __ ft. depth gage No. 320

10. Screen: Manufacturer's name Sunflower
Type styrene Dia. 5"
Slot/gauze 1/16" Length 80
Set between 301 ft. and 381 ft.
__ ft. and __ ft.
Gravel pack? X Size range of material ¼"

11. Static water level: mo./day/yr.
120 ft. below land surface Date 7/29/77

12. Pumping level below land surfaces:
250 ft. after 15 hrs. pumping 10 g.p.m.
__ ft. after __ hrs. pumping __ g.p.m.
Estimated maximum yield 15 g.p.m.

13. Water sample submitted: mo./day/yr.
__ Yes X No Date

14. Well head completion:
X Pitless adapter 24 Inches above grade

15. Well grouted? X
With: X Neat cement __ Bentonite __ Concrete
Depth: From 0 ft. to 10 ft.

16. Nearest source of possible contamination:
ft. __ Direction __ Type field
Well disinfected upon completion? X Yes __ No

17. Pump: X Not installed
Manufacturer's name
Model number HP Volts
Length of drop pipe ft. capacity g.p.m.
Type:
__ Submersible __ Turbine
__ Jet __ Reciprocating
__ Centrifugal __ Other

18. Elevation:

Topography:
__ Hill
✓ Slope
__ Upland
__ Valley

19. Remarks:
This well was drilled to determine the location of a future home.

20. Water well contractor's certification:
This well was drilled under my jurisdiction and this report is true to the best of my knowledge and belief.
Houck Bros. Drlg. Co., Inc. 164
Business name License No.
Address Box 487, Ulysses, Ks.
Signed M. Beard Date 7/29/77
Authorized representative

T 29 R 41 W Sec 20 SE¼ SE¼ SE¼

Forward the white, blue and pink copies to the Department of Health and Environment

Form WWC-5