

USE TYPEWRITER OR BALL POINT PEN—PRESS FIRMLY, PRINT CLEARLY.

T R EW sec 1/4 1/4 1/4 No.


WATER WELL RECORD
KSA 82a-1201-1215

Kansas State Dept. Of Health
(Water Well Contractors)
Forbes-Bldg. 740
Topeka, Kansas 66620

1 Location of well:	County Stanton	Township name	Fraction NE$\frac{1}{4}$ NE$\frac{1}{4}$ NE$\frac{1}{4}$	Section number 22	Town number 29S	Range number 41W
---------------------	--------------------------	---------------	---	-----------------------------	---------------------------	----------------------------

Distance and direction from nearest town or city: **From Johnson hiway intersection: 4 miles south, 1 mile west**
Street address of well location if in city:

3 Owner of well: **Frank Smith**
% Bob Irwin
Address: **Johnson, Ksan.**

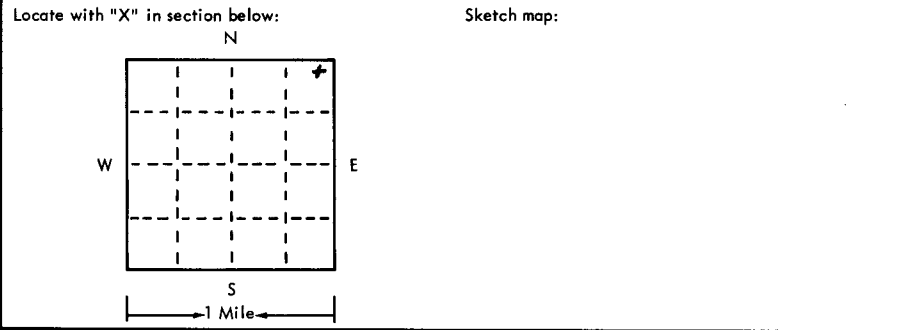

4 Well depth: **401** ft. Date of completion **8-9-75**
Well diameter **27** in.

5 Cable tool Rotary Driven Dug
 Hollow rod Jetted Bored Reverse rotary

6 Use: Domestic Public supply Industry
 Irrigation Air conditioning Commercial
 Test well

7 Casing: Material **stl** Height: **(above/below)**
Threaded Welded Surface **12** in.
Diam. **16"** Weight **36.8** lbs./ft. **1**
0 in. to **271.4** ft. depth Drive shoe? Yes No
— in. to — ft. depth

2 Type and color of material	From	To
Surface	0	2
Red & brown sandy clay	2	95
Medium to coarse sand	95	103
Brown sandy clay	103	120
Medium to coarse sand w/embedded strips	120	160
Sandy clay	160	181
Medium to coarse sand w/embedded strips	181	209
Embedded sand	209	225
Medium to coarse sand w/clay breakers	225	307
Embedded sand	307	316
Sandy clay, lime shale & medium sand strips ²⁻¹⁻¹⁻¹	316	334
Brown & sandy clay, tight	334	347
Brown sandy clay, w/medium strips 1-1-1-1	347	362
Medium to coarse sand	362	373
Sand rock, coarse sand Loose	373	387
Yellow chalk, brown shale & Dakota tight	387	397
False red bed, brown shale & yellow chalk tight (use a second sheet if needed)	397	420

8 Screen:
Manufacturer **Lakewood**
Type **stl** Dia. **16"**
Slot gauge **3/16** Length **2"** slot
Set between **271.4** and **401** ft.
Fittings:
Gravel pack Yes No Size range of material **1/4 x 5/8**

9 Static water level:
230 ft. below land surface Date **6-27-75**

10 Pumping level below land surfaces:
325 ft. after **24** hrs. pumping **700** g.p.m.
325 ft. after **40** hrs. pumping **900** g.p.m.
Estimated maximum yield **1000** g.p.m.

11 Water sample submitted:
 Yes No Date _____

12 Well head completion:
 Pitless adapter **2** inches above grade

13 Well grouted? Yes No
 Neat cement Bentonite _____
Depth: From **0** ft. to **10** ft.

14 Nearest source of possible contamination:
ft. **2 mi** Direction **NA** Type **NA**
Well disinfected upon completion? Yes No

15 Pump: Not installed
Manufacturer's name _____
Model number _____ HP _____ Volts _____
Length of drop pipe _____ ft. capacity _____ g.p.m.
Type:
 Submersible Turbine
 Jet Reciprocating
 Centrifugal Other

16 Remarks: elevation

Topography:
 Hill
 Slope
 Upland
 Valley

17 Water well contractor's certification:
This well was drilled under my jurisdiction and this report is true to the best of my knowledge and belief.
Houck Bros. Drlg. Co. 164
Business name License No. _____
Address **Box 487, Ulysses, Ks.**
Signed **M. Beard** Date **8/29/75**
Authorized representative