

USE TYPEWRITER OR BALL POINT PEN-PRESS FIRMLY, PRINT CLEARLY.

T R EW sec 1/4 1/4 1/4 No.

WATER WELL RECORD
KSA 82a-1201-1215


Kansas State Dept. Of Health
(Water Well Contractors)
Forbes-Bldg. 740
Topeka, Kansas 66620

1 Location of well:	County Stanton	Township name Stanton	Fraction SE$\frac{1}{4}$ SW$\frac{1}{4}$ SW$\frac{1}{4}$	Section number 28	Town number 29S	Range number 41W
---------------------	--------------------------	---------------------------------	---	-----------------------------	---------------------------	----------------------------

Distance and direction from nearest town or city: **Hiway 160-27 inter-section at Johnson, 7 miles south 2 $\frac{1}{2}$ miles west**

3 Owner of well: **Olie Cockreham Johnson, Kansas**

Address:

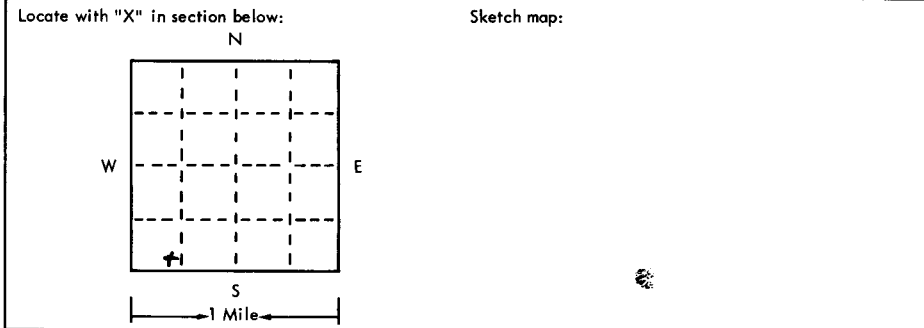

4 Well depth: 352 ft. Date of completion 5/28/75
Well diameter 27 in.

5 Cable tool Rotary Driven Dug
 Hollow rod Jetted Bored Reverse rotary

6 Use: Domestic Public supply Industry
 Irrigation Air conditioning Commercial
 Test well

7 Casing: Material stl Height: above/below
Threaded Welded Surface 12 in.
Diam. 16" Weight 36.8 lbs./ft. 1
0 in. to 230 ft. Drive shoe? Yes No
— in. to — ft. depth!

2 Type and color of material	From	To
Surface	0	2
Sandy clay w/lime shells	2	72
Fine to medium sand	72	103
Brown clay w/fine sand strips	103	135
Brown and gray clay w/sandstone	135	175
Sandstone (lost circulation)	175	225
Blue shale	225	280
Brown shale & sandstone 25% fair	280	500
%		
(use a second sheet if needed)		

8 Screen: Manufacturer LK Lakewood
Type Stl Dia. 16"
(Slot) gauze 3/16 Length 2" slot
Set from 230.5 to 352 ft.
Fittings: Gravel pack Yes No Size range of material 1/2 x 5/8

9 Static water level: 205 ft. below land surface Date 5/18/75

10 Pumping level below land surfaces:
275 ft. after 10 hrs. pumping 600 g.p.m.
275 ft. after 15 hrs. pumping 700 g.p.m.
Estimated maximum yield 700 g.p.m.

11 Water sample submitted:
 Yes No Date —

12 Well head completion:
 Pitless adapter 10 inches above grade

13 Well grouted? Yes No
 Neat cement Bentonite —
Depth: From 0 ft. to 10 ft.

14 Nearest source of possible contamination:
ft. — Direction — Type NA
Well disinfected upon completion? Yes No

15 Pump: Not installed
Manufacturer's name —
Model number — HP — Volts —
Length of drop pipe — ft. capacity — g.m.p.
Type: Submersible Turbine
 Jet Reciprocating
 Centrifugal Other

16 Remarks: elevation

Topography:
 Hill
 Slope
 Upland
 Valley

17 Water well contractor's certification:
This well was drilled under my jurisdiction and this report is true to the best of my knowledge and belief.

Houck Bros. Drlg. Co. 164
Business name License No.
Address Box 487, Ulysses, KS.
Signed M. Beard Date 8/15/75
Authorized representative