

USE TYPEWRITER OR BALL POINT PEN-PRESS FIRMLY, PRINT CLEARLY.


T R EW sec 1/4 1/4 1/4 No.

WATER WELL RECORD
KSA 82a-1201-1215

Kansas State Dept. Of Health
(Water Well Contractors)
Forbes-Bldg. 740
Topeka, Kansas 66620

1 Location of well:	County Stanton	Township name Stanton	Fraction NW¹/₄ NW¹/₄ NW¹/₄	Section number 34	Town number 29S	Range number 41W
---------------------	--------------------------	---------------------------------	--	-----------------------------	---------------------------	----------------------------

Distance and direction from nearest town or city: Street address of well location if in city: Hiway intersection at Johnson 6 miles south 1 1/2 miles west	3 Owner of well: Address: Olie Cockreham Johnson, Kansas
---	---

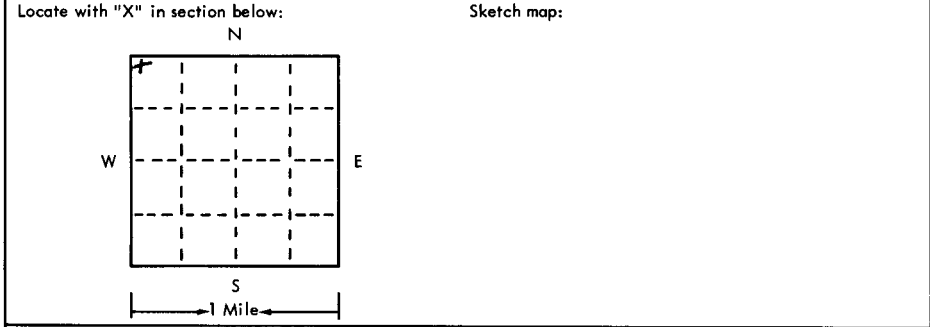

4 Well depth: <u>504.5</u> ft. Date of completion <u>6-12-75</u> Well diameter <u>27</u> in.
5 <input type="checkbox"/> Cable tool <input checked="" type="checkbox"/> Rotary <input type="checkbox"/> Driven <input type="checkbox"/> Dug <input type="checkbox"/> Hollow rod <input type="checkbox"/> Jetted <input type="checkbox"/> Bored <input type="checkbox"/> Reverse rotary
6 Use: <input type="checkbox"/> Domestic <input type="checkbox"/> Public supply <input type="checkbox"/> Industry <input checked="" type="checkbox"/> Irrigation <input type="checkbox"/> Air conditioning <input type="checkbox"/> Commercial <input type="checkbox"/> Test well <input type="checkbox"/>
7 Casing: Material <u>stl</u> Height: <u>above</u> /below Threaded <input type="checkbox"/> Welded <input checked="" type="checkbox"/> Surface <u>12</u> in. Diam. <u>16</u> " Weight <u>36.8</u> lbs./ft. <u>1</u> <u>0</u> in. to <u>216</u> ft. Depth Drive shoe? <input type="checkbox"/> Yes <input checked="" type="checkbox"/> No <u> </u> in. to <u> </u> ft. depth!

2 Type and color of material	From	To
Surface	0	2
Sandy clay	2	100
Medium sand w/clay breakers	100	180
Clay w/sandstone strips	180	195
Sandstone (lost circulation)	195	240
Blue shale w/sandstone (very hard)	240	318
White sandstone	318	540
(use a second sheet if needed)		

8 Screen: Manufacturer <u>Lakewood</u> Type <u>stl</u> Dia. <u>16</u> " <input checked="" type="checkbox"/> Slot gauze <u>3/16</u> Length <u>2" slot</u> Set <u>from 216 ft and to 504.5</u> Fittings: Gravel pack <input type="checkbox"/> Yes <input type="checkbox"/> No Size range of material <u>1/2 x 5/8</u>
9 Static water level: <u>195</u> ft. below land surface Date <u>5/14/75</u>
10 Pumping level below land surfaces: <u>400</u> ft. after <u>10</u> hrs. pumping <u>325</u> g.p.m. <u>400</u> ft. after <u>20</u> hrs. pumping <u>375</u> g.p.m. Estimated maximum yield <u>375</u> g.p.m.
11 Water sample submitted: <input type="checkbox"/> Yes <input checked="" type="checkbox"/> No Date <u> </u>
12 Well head completion: <input type="checkbox"/> Pitless adapter <u>10</u> inches above grade
13 Well grouted? <input checked="" type="checkbox"/> Yes <input type="checkbox"/> No <input checked="" type="checkbox"/> Neat cement <input type="checkbox"/> Bentonite <input type="checkbox"/> Depth: From <u>0</u> ft. to <u>10</u> ft.
14 Nearest source of possible contamination: ft. <u> </u> Direction <u> </u> Type <u>NA</u> Well disinfected upon completion? <input type="checkbox"/> Yes <input checked="" type="checkbox"/> No
15 Pump: <input checked="" type="checkbox"/> Not installed Manufacturer's name <u> </u> Model number <u> </u> HP <u> </u> Volts <u> </u> Length of drop pipe <u> </u> ft. capacity <u> </u> g.m.p. Type: <input type="checkbox"/> Submersible <input type="checkbox"/> Turbine <input type="checkbox"/> Jet <input type="checkbox"/> Reciprocating <input type="checkbox"/> Centrifugal <input type="checkbox"/> Other

16 Remarks: elevation

Topography:
 Hill
 Slope
 Upland
 Valley

17 Water well contractor's certification:
This well was drilled under my jurisdiction and this report is true to the best of my knowledge and belief.
Houck Bros. Drlg. Co. 164
Business name License No.
Address Box 487, Ulysses, Ks.
Signed M. Beard Date 8-15-75
Authorized representative