


WATER WELL RECORD Form WWC-5 KSA 82a-1212

1 LOCATION OF WATER WELL:	Fraction	Section Number	Township Number	Range Number
County: STANTON	SW ¼ NW ¼ SW ¼	13	T 29S S	R 41W EW

Distance and direction from nearest town or city street address of well if located within city?
~~XXXX~~ 6½ MILES EAST MANTER, KS

2 WATER WELL OWNER: HUBER J M CORP RR#, St. Address, Box # : 7120 I-40 WEST STE 100 City, State, ZIP Code : AMARILLO TX	#13-1 ARNOLD RICHARD Board of Agriculture, Division of Water Resources Application Number: 940406
---	--

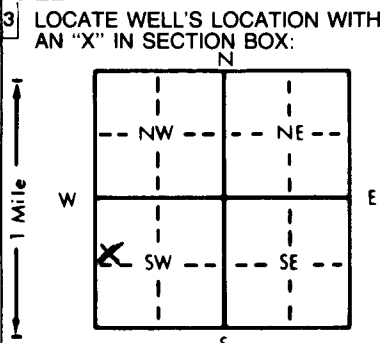

4 DEPTH OF COMPLETED WELL: 460 ft. ELEVATION:

Depth(s) Groundwater Encountered 1. 210 ft. 2. ft. 3. ft.

WELL'S STATIC WATER LEVEL: 210 ft. below land surface measured on mo/day/yr 10-19-94

Pump test data: Well water was 230 ft. after 1 hours pumping 90 gpm

Est. Yield 90 gpm: Well water was ft. after hours pumping gpm

Bore Hole Diameter: 11 in. to 460 ft., and in. to ft.

WELL WATER TO BE USED AS:

1 Domestic	3 Feedlot	6 Oil field water supply	9 Dewatering	12 Other (Specify below)
2 Irrigation	4 Industrial	7 Lawn and garden only	10 Monitoring well	

5 Public water supply 8 Air conditioning 11 Injection well

Was a chemical/bacteriological sample submitted to Department? Yes.....No...X.....; If yes, mo/day/yr sample was submitted

Water Well Disinfected? Yes X No

5 TYPE OF BLANK CASING USED:

1 Steel	3 RMP (SR)	5 Wrought iron	8 Concrete tile	CASING JOINTS: Glued X Clamped
2 PVC	4 ABS	6 Asbestos-Cement	9 Other (specify below)	Welded
		7 Fiberglass		Threaded

Blank casing diameter: 6 in. to 460 ft., Dia. in. to ft., Dia. in. to ft.

Casing height above land surface: 24 in., weight 2,902 lbs./ft. Wall thickness or gauge No. .316 SDR 21

TYPE OF SCREEN OR PERFORATION MATERIAL:

1 Steel	3 Stainless steel	5 Fiberglass	8 RMP (SR)	10 Asbestos-cement
2 Brass	4 Galvanized steel	6 Concrete tile	9 ABS	11 Other (specify)
				12 None used (open hole)

SCREEN OR PERFORATION OPENINGS ARE:

1 Continuous slot	3 Mill slot	5 Gauzed wrapped	8 Saw cut	11 None (open hole)
2 Louvered shutter	4 Key punched	6 Wire wrapped	9 Drilled holes	
		7 Torch cut	10 Other (specify)	

SCREEN-PERFORATED INTERVALS: From 340 ft. to 460 ft., From ft. to ft.

GRAVEL PACK INTERVALS: From 320 ft. to 460 ft., From ft. to ft.

6 GROUT MATERIAL: 1 Neat cement 2 Cement grout 3 Bentonite 4 Other HOLE PLUG

Grout Intervals: From 1 ft. to 20 ft., From ft. to ft., From ft. to ft.

What is the nearest source of possible contamination:

1 Septic tank	4 Lateral lines	7 Pit privy	10 Livestock pens	14 Abandoned water well
2 Sewer lines	5 Cess pool	8 Sewage lagoon	11 Fuel storage	15 Oil well/Gas well
3 Watertight sewer lines	6 Seepage pit	9 Feedyard	12 Fertilizer storage	16 Other (specify below)
			13 Insecticide storage	

Direction from well? How many feet?

FROM	TO	LITHOLOGIC LOG	FROM	TO	PLUGGING INTERVALS
0	2	TOP CLAY	346	362	SAND
2	43	CLAY	362	409	SANDY CLAY
43	50	SANDY CLAY	409	419	SAND
50	91	CLAY	419	422	RED CLAY
91	129	SANDY CLAY	422	436	SAND & SANDY CLAY
129	152	SAND	436	439	RED CLAY
152	173	SANDY CLAY	439	451	SANDY CLAY
173	183	SAND	451	460	RED, YELLOW & BLUE CLAY
183	207	CLAY			
207	224	SANDY CLAY			
224	256	SAND			
256	274	CLAY			
274	286	SANDY CLAY			
286	335	CLAY			
335	346	SANDY CLAY			

7 CONTRACTOR'S OR LANDOWNER'S CERTIFICATION: This water well was (1) constructed, (2) reconstructed, or (3) plugged under my jurisdiction and was completed on (mo/day/year) 10-19-94 and this record is true to the best of my knowledge and belief. Kansas Water Well Contractor's License No. KWWCL-430 This Water Well Record was completed on (mo/day/yr) 10-19-94 under the business name of HOWARD DRUG CO. BOX 806 BEAVER, OK 73932 by (signature) *Howard*

INSTRUCTIONS: Use typewriter or ball point pen. PLEASE PRESS FIRMLY and PRINT clearly. Please fill in blanks, underline or circle the correct answers. Send three copies to Kansas Department of Health and Environment, Bureau of Water, Topeka, Kansas 66620-0001. Telephone: 913-296-5545. Send one to WATER WELL OWNER and retain one for your records.