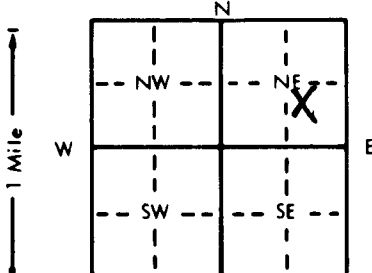


1 LOCATION OF WATER WELL: County: STANTON	Fraction NW 1/4 SE 1/4 NE 1/4	Section Number 6	Township Number T 29 S	Range Number R 41 W EW
--	----------------------------------	---------------------	---------------------------	---------------------------

Distance and direction from nearest town or city street address of well if located within city?

3 MILES NORTHEAST MANTER, KS

2 WATER WELL OWNER: HUBER J. M. CORP. RR#, St. Address, Box # : 7120 I-40 WEST STE 100 City, State, ZIP Code : AMARILLO, TX 79106	#6-1 DORR Board of Agriculture, Division of Water Resources Application Number: 940469
---	--

3 LOCATE WELL'S LOCATION WITH AN "X" IN SECTION BOX: 	4 DEPTH OF COMPLETED WELL: 340 ft. ELEVATION: Depth(s) Groundwater Encountered 1. 230 ft. 2. ft. 3. ft. WELL'S STATIC WATER LEVEL: 230 ft. below land surface measured on mo/day/yr 11-29-94 Pump test data: Well water was 250 ft. after 1 hours pumping 100 gpm Est. Yield 100 gpm: Well water was ft. after hours pumping gpm Bore Hole Diameter 11 in. to 340 ft. and in. to ft. WELL WATER TO BE USED AS: 1 Domestic 3 Feedlot 6 Oil field water supply 9 Dewatering 11 Injection well 2 Irrigation 4 Industrial 7 Lawn and garden only 10 Monitoring well 12 Other (Specify below) Was a chemical/bacteriological sample submitted to Department? Yes No X; If yes, mo/day/yr sample was submitted Water Well Disinfected? Yes X No
--	---

5 TYPE OF BLANK CASING USED: 1 Steel 3 RMP (SR) 5 Wrought iron 8 Concrete tile 2 PVC 4 ABS 6 Asbestos-Cement 9 Other (specify below) Blank casing diameter 6 in. to 340 ft. Dia. in. to ft. Dia. in. to ft. Casing height above land surface 24 in. weight 2.902 lbs./ft. Wall thickness or gauge No. 280 SDR 21 TYPE OF SCREEN OR PERFORATION MATERIAL: 1 Steel 3 Stainless steel 5 Fiberglass 7 PVC 10 Asbestos-cement 2 Brass 4 Galvanized steel 6 Concrete tile 8 RMP (SR) 11 Other (specify) 12 None used (open hole) SCREEN OR PERFORATION OPENINGS ARE: 1 Continuous slot 3 Mill slot 5 Gauzed wrapped 8 Saw cut 11 None (open hole) 2 Louvered shutter 4 Key punched 6 Wire wrapped 9 Drilled holes 10 Other (specify) SCREEN-PERFORATED INTERVALS: From 260 ft. to 340 ft. From ft. to ft. From 240 ft. to 340 ft. From ft. to ft. GRAVEL PACK INTERVALS: From ft. to ft. From ft. to ft. From ft. to ft. From ft. to ft.

6 GROUT MATERIAL: 1 Neat cement 2 Cement grout 3 Bentonite 4 Other HOLE PLUG Grout Intervals: From 1 ft. to 20 ft. From ft. to ft. From ft. to ft. What is the nearest source of possible contamination: 1 Septic tank 4 Lateral lines 7 Pit privy 10 Livestock pens 14 Abandoned water well 2 Sewer lines 5 Cess pool 8 Sewage lagoon 11 Fuel storage 15 Oil well/Gas well 3 Watertight sewer line 6 Seepage pit 9 Feedyard 12 Fertilizer storage 16 Other (specify below) 13 Insecticide storage Direction from well? Southwest How many feet? 2000
--

FROM	TO	LITHOLOGIC LOG	FROM	TO	PLUGGING INTERVALS
0	2	SANDY CLAY	300	311	HARD CLAY
2	13	SAND	311	320	SAND
13	38	CLAY & SANDY CLAY	320	340	SANDY CLAY
38	62	SANDY CLAY			
62	83	MED. GRAVEL W/CLAY STREAKS			
83	91	CLAY			
91	112	SANDY CLAY			
112	127	CLAY			
127	152	CLAY & SANDY CLAY			
152	202	CLAY			
202	218	SANDY CLAY			
218	228	SAND			
228	286	SAND			
286	291	CLAY			
291	300	SAND			

7 CONTRACTOR'S OR LANDOWNER'S CERTIFICATION: This water well was (1) constructed, (2) reconstructed, or (3) plugged under my jurisdiction and was completed on (mo/day/year) 11-29-94 and this record is true to the best of my knowledge and belief. Kansas Water Well Contractor's License No. KWWCL-430 This Water Well Record was completed on (mo/day/yr) 11-29-94 under the business name of HOWARD DRIG.CO.BOX 806 BEAVER, OK 73932 by (signature) <i>Alvin Herring</i>
--

INSTRUCTIONS: Use typewriter or ball point pen. PLEASE PRESS FIRMLY and PRINT clearly. Please fill in blanks, underline or circle the correct answers. Send top three copies to Kansas Department of Health and Environment, Bureau of Water, Topeka, Kansas 66620-0001. Telephone: 913-296-5545. Send one to WATER WELL OWNER and retain one for your records.