


1] LOCATION OF WATER WELL: County: Stanton Fraction: NW 1/4 SW 1/4 SW 1/4 Section Number: 14 Township Number: T 29 S Range Number: R 42 EW

Distance and direction from nearest town or city street address of well if located within city?
Middle of Alley between Madison + Monroe streets ~ 100' N. of Hwy 160, Manter KS

2] WATER WELL OWNER: Collingwood Grain RR#, St. Address, Box #: Box 127 (on Hwy 160) City, State, ZIP Code: Manter, KS 67867 Board of Agriculture, Division of Water Resources Application Number: NW-2

3] LOCATE WELL'S LOCATION WITH AN "X" IN SECTION BOX:

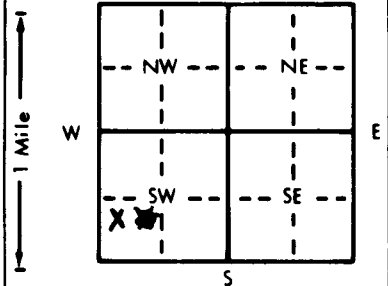

4] DEPTH OF COMPLETED WELL: 90 ft. ELEVATION: 3489.63

Depth(s) Groundwater Encountered 1. 76 ft. 2. _____ ft. 3. _____ ft.
 WELL'S STATIC WATER LEVEL 76.35 ft. below land surface measured on mo/day/yr 6/22/95
 Pump test data: Well water was _____ ft. after _____ hours pumping _____ gpm
 Est. Yield _____ gpm: Well water was _____ ft. after _____ hours pumping _____ gpm
 Bore Hole Diameter 8 in. to 90 ft., and _____ in. to _____ ft.
 WELL WATER TO BE USED AS: 5 Public water supply 8 Air conditioning 11 Injection well
 1 Domestic 3 Feedlot 6 Oil field water supply 9 Dewatering 12 Other (Specify below)
 2 Irrigation 4 Industrial 7 Lawn and garden only 10 Monitoring well
 Was a chemical/bacteriological sample submitted to Department? Yes No; If yes, mo/day/yr sample was submitted
 Water Well Disinfected? Yes No

5] TYPE OF BLANK CASING USED: 1 Steel 3 RMP (SR) 5 Wrought iron 8 Concrete tile CASING JOINTS: Glued _____ Clamped _____
 PVC 4 ABS 7 Fiberglass _____ Welded _____
 Blank casing diameter 6.5 in. to _____ ft., Dia _____ in. to _____ ft., Dia _____ in. to _____ ft.
 Casing height above land surface 0 (Flush Mt.) in., weight _____ lbs./ft. Wall thickness or gauge No. _____

TYPE OF SCREEN OR PERFORATION MATERIAL: PVC 10 Asbestos-cement
 1 Steel 3 Stainless steel 5 Fiberglass 8 RMP (SR) 11 Other (specify) _____
 2 Brass 4 Galvanized steel 6 Concrete tile 9 ABS 12 None used (open hole)

SCREEN OR PERFORATION OPENINGS ARE: 5 Gauzed wrapped 8 Saw cut 11 None (open hole)
 1 Continuous slot Mill slot 6 Wire wrapped 9 Drilled holes
 2 Louvered shutter 4 Key punched 7 Torch cut 10 Other (specify) _____

SCREEN-PERFORATED INTERVALS: From 6.5 ft. to 90 ft., From _____ ft. to _____ ft.
 From _____ ft. to _____ ft., From _____ ft. to _____ ft.
 GRAVEL PACK INTERVALS: From 6.3 ft. to 90 ft., From _____ ft. to _____ ft.
 From _____ ft. to _____ ft., From _____ ft. to _____ ft.

6] GROUT MATERIAL: 1 Neat cement Cement grout Bentonite 4 Other _____
 Grout intervals: From 0 ft. to 6.1 ft., From 6.1 ft. to 6.3 ft., From _____ ft. to _____ ft.

What is the nearest source of possible contamination: 10 Livestock pens 14 Abandoned water well
 1 Septic tank 4 Lateral lines 7 Pit privy Fuel storage 15 Oil well/Gas well
 2 Sewer lines 5 Cess pool 8 Sewage lagoon 12 Fertilizer storage 16 Other (specify below)
 3 Watertight sewer lines 6 Seepage pit 9 Feedyard 13 Insecticide storage _____
 Direction from well? South How many feet? 300

FROM	TO	LITHOLOGIC LOG	FROM	TO	PLUGGING INTERVALS
0	7'	clay, w/silt, brown			
7'	15'	clay, w/silt + sand, brown			
15'	22'	clay, w/silt, brown			
22'	40'	clay, w/silt + sand, reddish brown			
40'	60'	clay, w/silt + sand, reddish brn.			
60'	72'	Sand, w/silt, brown, w/cheert			
72'	90'	Sand, w/silt + caliche, brown			

7] CONTRACTOR'S OR LANDOWNER'S CERTIFICATION: This water well was constructed, (2) reconstructed, or (3) plugged under my jurisdiction and was completed on (mo/day/year) 6/3/95 and this record is true to the best of my knowledge and belief. Kansas Water Well Contractor's License No. 438 This Water Well Record was completed on (mo/day/yr) 7/19/95 under the business name of Kansas City Testing Lab by (signature) Charles Hunter