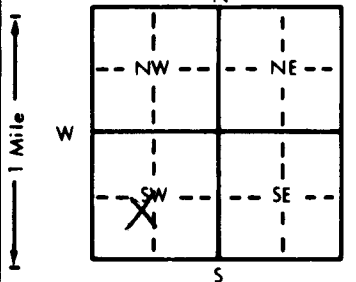


1 LOCATION OF WATER WELL:	Fraction	Section Number	Township Number	Range Number
County: <u>Stanton</u>	<u>NE 1/4 SW 1/4 SW 1/4</u>	<u>14</u>	<u>T 29 S</u>	<u>R 42</u> <u>EW</u>

Distance and direction from nearest town or city street address of well if located within city?

2 WATER WELL OWNER:	Board of Agriculture, Division of Water Resources
RR#, St. Address, Box # : <u>Johnson Grain Co.</u>	MW# <u>15</u> Application Number:
City, State, ZIP Code : <u>Manter, Ks.</u>	

3 LOCATE WELL'S LOCATION WITH AN "X" IN SECTION BOX:	4 DEPTH OF COMPLETED WELL: <u>89</u> ft. ELEVATION:
	Depth(s) Groundwater Encountered 1. ft. 2. ft. 3. ft. WELL'S STATIC WATER LEVEL <u>74.56</u> ft. below land surface measured on mo/day/yr Pump test data: Well water was ft. after hours pumping gpm Est. Yield gpm: Well water was ft. after hours pumping gpm Bore Hole Diameter .. <u>8</u> in. to .. <u>8.9</u> ft., and in. to ft. WELL WATER TO BE USED AS: 5 Public water supply 8 Air conditioning 11 Injection well 1 Domestic 3 Feedlot 6 Oil field water supply 9 Dewatering 12 Other (Specify below) 2 Irrigation 4 Industrial 7 Lawn and garden only 10 Monitoring well Was a chemical/bacteriological sample submitted to Department? Yes No <u>X</u> If yes, mo/day/yr sample was submitted Water Well Disinfected? Yes No <u>X</u>

5 TYPE OF BLANK CASING USED:	5 Wrought iron	8 Concrete tile	CASING JOINTS: Glued Clamped	
1 Steel	3 RMP (SR)	6 Asbestos-Cement	9 Other (specify below)	Welded
2 PVC	4 ABS	7 Fiberglass		Threaded <u>X</u>
Blank casing diameter <u>2</u> in. to <u>64</u> ft., Dia. in. to ft., Dia. in. to ft.				
Casing height above land surface <u>0</u> in., weight <u>.716</u> lbs./ft. Wall thickness or gauge No. <u>.154</u>				
TYPE OF SCREEN OR PERFORATION MATERIAL:	7 PVC	10 Asbestos-cement		
1 Steel	3 Stainless steel	5 Fiberglass	8 RMP (SR)	11 Other (specify)
2 Brass	4 Galvanized steel	6 Concrete tile	9 ABS	12 None used (open hole)
SCREEN OR PERFORATION OPENINGS ARE:	5 Gauzed wrapped	8 Saw cut	11 None (open hole)	
1 Continuous slot	3 Mill slot	6 Wire wrapped	9 Drilled holes	
2 Louvered shutter	4 Key punched	7 Torch cut	10 Other (specify)	
SCREEN-PERFORATED INTERVALS: From <u>64</u> ft. to <u>89</u> ft., From ft. to ft.				
GRAVEL PACK INTERVALS: From <u>54</u> ft. to <u>89</u> ft., From ft. to ft.				

6 GROUT MATERIAL:	1 Neat cement	2 Cement grout	3 Bentonite	4 Other	
Grout Intervals: From <u>0</u> ft. to <u>51</u> ft., From <u>51</u> ft. to <u>54</u> ft., From ft. to ft.					
What is the nearest source of possible contamination:	1 Septic tank	4 Lateral lines	7 Pit privy	10 Livestock pens	14 Abandoned water well
	2 Sewer lines	5 Cess pool	8 Sewage lagoon	11 Fuel storage	15 Oil well/Gas well
	3 Watertight sewer lines	6 Seepage pit	9 Feedyard	12 Fertilizer storage	16 Other (specify below)
				13 Insecticide storage	<u>Removed Fuel Storage</u>
Direction from well?				How many feet?	

FROM	TO	LITHOLOGIC LOG	FROM	TO	PLUGGING INTERVALS
0	2	Surface			
2	10	Loess			
10	20	Clay & Caliche			
20	40	Hard Clay & Caliche			
40	46	Sandy Clay w/Sand Strks.			
46	54	Med. Sand & Gravel w/a Few Clay Lenses			
54	58	Cem. Sand w/Med. Sand & Some Clay			
58	62	Med. Sand & Gravelw/Clay Lns.			
62	69	Med. Sand w/Cem. Sand Strks.			
69	73	Cem. Sand & Med. Sand Strks.			
73	79	Sandy Clay w/a Few Sand Strks.			
79	84	Med. Sand & Gravel			
84	89	Cemented Sand			

7 CONTRACTOR'S OR LANDOWNER'S CERTIFICATION: This water well was (1) constructed, (2) reconstructed, or (3) plugged under my jurisdiction and was completed on (mo/day/year) <u>12-6-96</u> and this record is true to the best of my knowledge and belief. Kansas Water Well Contractor's License No. <u>554</u> This Water Well Record was completed on (mo/day/yr) <u>1-7-97</u> under the business name of <u>Woofter Pump & Well, Inc.</u> by (signature) <u>[Signature]</u>
