


1 LOCATION OF WATER WELL: County: Stanton	Fraction SE ¼ SW ¼ SW ¼	Section Number 14	Township Number T 29 S	Range Number R 42 EW
---	-----------------------------------	-----------------------------	----------------------------------	---------------------------------------

Distance and direction from nearest town or city street address of well if located within city?

Johnson Coop Grain, Manter, Kansas

2 WATER WELL OWNER: Johnson Coop Grain-Manter RR#, St Address, Box# : South 160 Highway City, State, ZIP Code : Manter, Kansas	REVISED 3/98	Board of Agriculture, Division of Water Resources Application Number:
--	---------------------	--

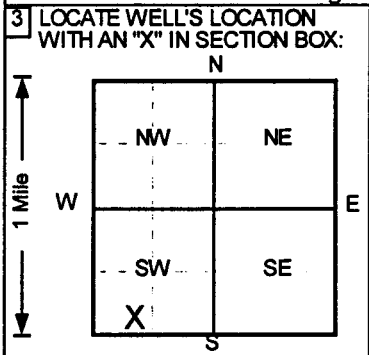

4 DEPTH OF COMPLETED WELL..... 65 ft. ELEVATION: 0
Depth(s) Groundwater Encountered 1..... ft 2..... ft 3..... ft.
WELL'S STATIC WATER LEVEL ft. below land surface measured on mo/day/yr
Pump test data: Well water was NA ft. after hours pumping gpm
Est. Yield .. NA .. gpm: Well water was ft. after hours pumping gpm
Bore Hole Diameter 8 in. to 70 ft., and in. to ft.
WELL WATER TO BE USED AS:
5 Public water supply 8 Air conditioning 11 Injection well
1 Domestic 3 Feedlot 6 Oil field water supply 9 Dewatering 12 Other (Specify below)
2 Irrigation 4 Industrial 7 Lawn and garden only 10 Monitoring well
Was a chemical/bacteriological sample submitted to Department? Yes.....No ✓; If yes, mo/day/yr sample was submitted
Water Well Disinfected? Yes No ✓

5 TYPE OF BLANK CASING USED:	5 Wrought iron	8 Concrete tile	CASING JOINTS: Glued Clamped
1 Steel 3 RMP (SR)	6 Asbestos-Cement	9 Other (specify below)	Welded
2 PVC 4 ABS	7 Fiberglass		Threaded. ✓
Blank casing diameter 2 in. to 55 ft, Dia in. to ft, Dia in. to ft			
Casing height above land surface 0 in., weight Sch 40 lbs./ft. Wall thickness or gauge No.			
TYPE OF SCREEN OR PERFORATION MATERIAL			
1 Steel 3 Stainless steel 5 Fiberglass 7 PVC 10 Asbestos-cement			
2 Brass 4 Galvanized steel 6 Concrete tile 8 RMP (SR) 11 Other (specify)			
			12 None used (open hole)
SCREEN OR PERFORATION OPENINGS ARE:			
1 Continuous slot 3 Mill slot	5 Gauzed wrapped	8 Saw cut	11 None (open hole)
2 Louvered shutter 4 Key punched	6 Wire wrapped	9 Drilled holes	
	7 Torch cut	10 Other (specify)	
SCREEN-PERFORATED INTERVALS: From 55 ft to 70 ft, From ft to ft			
GRAVEL PACK INTERVALS: From 53 ft to 70 ft, From ft to ft			

6 GROUT MATERIAL:	1 Neat cement	2 Cement grout	3 Bentonite	4 Other
GROUT INTERVALS: From 0 ft to 50 ft, From 50 ft to 53 ft, From ft to ft				
What is the nearest source of possible contamination:				
1 Septic tank	4 Lateral lines	7 Pit privy	10 Livestock pens	14 Abandoned water well
2 Sewer lines	5 Cess pool	8 Sewage lagoon	11 Fuel storage	15 Oil well/Gas well
3 Watertight sewer lines	6 Seepage pit	9 Feedyard	12 Fertilizer storage	16 Other (specify below)
			13 Insecticide storage Unknown
Direction from well? How many feet? 0				

FROM	TO	LITHOLOGIC LOG	FROM	TO	PLUGGING INTERVALS
0	0.5	Concrete,			
0.5	1.5	Sand, Brown			
1.5	6	Clay, Brown			
6	19	Clay, Light Brown/Light Red Brown			
19	42	Clay, Red Brown			
42	65	Sand, Light Red Brown			
					SVE1, Tag #, Flushmount
					Project Name: AG -W - Manter
					GeoCore # 592 , #

7 CONTRACTOR'S OR LANDOWNER'S CERTIFICATION: This water well was **(1)** constructed, **(2)** reconstructed, or **(3)** plugged under my jurisdiction and was completed on (mo/day/year) **11/21/97** and this record is true to the best of my knowledge and belief.

Kansas Water Well Contractor's License No. **527** This Water Well Record was completed on (mo/day/yr) **12/30/97**
under the business name of **GeoCore Services, Inc.** by (signature) *[Signature]*

INSTRUCTIONS: Use typewriter or ball point pen. PLEASE PRESS FIRMLY and PRINT clearly. Please fill in blanks, underline or circle the correct answers. Send top three copies to Kansas Department of Health and Environment, Bureau of Water, Topeka, Kansas 66620-0001. Telephone: 913-298-5545. Send one to WATER WELL OWNER and retain one for your records.

OFFICE USE ONLY

T

R

EW

SEC.

1/4

1/4

1/4