


WATER WELL RECORD Form WWC-5 KSA 82a-1212

1 LOCATION OF WATER WELL: County: Stanton Fraction SE 1/4 SW 1/4 SW 1/4 Section Number 14 Township Number T 29 S Range Number R 42 EW

Distance and direction from nearest town or city street address of well if located within city? Johnson Coop grain, Manter, Kansas

2 WATER WELL OWNER: Johnson Coop Grain-Manter RR#, St. Address, Box #: South Highway 160 Board of Agriculture, Division of Water Resources City, State, ZIP Code: Manter, Kansas Application Number:

3 LOCATE WELL'S LOCATION WITH AN "X" IN SECTION BOX:

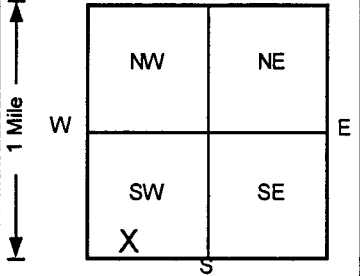

4 DEPTH OF COMPLETED WELL 85 ft ELEVATION: ft Depth(s) Groundwater Encountered 1. ft 2. ft 3. ft WELL'S STATIC WATER LEVEL 999 ft below land surface measured on mo/day/yr Pump test data: Well water was NA ft after hours pumping gpm Est. Yield NA gpm Well water was ft after hours pumping gpm Bore Hole Diameter 8 in. to 85 ft, and in. to ft WELL WATER TO BE USED AS: 5 Public water supply 8 Air conditioning 11 Injection well 1 Domestic 3 Feedlot 6 Oil field water supply 9 Dewatering 12 Other (Specify below) 2 Irrigation 4 Industrial 7 Lawn and garden only 10 Monitoring well Was a chemical/bacteriological sample submitted? Yes.....No.....; If yes, mo/day/yr sample was submitted Water Well Disinfected? Yes No

5 TYPE OF BLANK CASING USED: 1 Steel 2 PVC 3 RMP (SR) 4 ABS 5 Wrought iron 6 Asbestos-Cement 7 Fiberglass 8 Concrete tile 9 Other (specify below) CASING JOINTS: Glued Clamped Welded Threaded

Blank casing diameter 2 in. to 60 ft, Dia in. to ft, Dia in. to ft Casing height above land surface 0 in., weight Sch 40 lbs./ft. Wall thickness or gauge No.

TYPE OF SCREEN OR PERFORATION MATERIAL 1 Steel 2 Brass 3 Stainless steel 4 Galvanized steel 5 Fiberglass 6 Concrete tile 7 PVC 8 RMP (SR) 9 ABS 10 Asbestos-cement 11 Other (specify) 12 None used (open hole)

SCREEN OR PERFORATION OPENINGS ARE: 1 Continuous slot 2 Louvered shutter 3 Mill slot 4 Key punched 5 Gauzed wrapped 6 Wire wrapped 7 Torch cut 8 Saw cut 9 Drilled holes 11 None (open hole) 10 Other (specify)

SCREEN-PERFORATED INTERVALS: From 60 ft to 85 ft, From ft to ft From ft to ft, From ft to ft GRAVEL PACK INTERVALS: From 57 ft to 85 ft, From ft to ft From ft to ft, From ft to ft

6 GROUT MATERIAL: 1 Neat cement 2 Cement grout 3 Bentonite 4 Other Grout Intervals: From 0 ft to 54 ft, From 54 ft to 57 ft, From ft to ft

What is the nearest source of possible contamination: 1 Septic tank 2 Sewer lines 3 Watertight sewer lines 4 Lateral lines 5 Cess pool 6 Seepage pit 7 Pit privy 8 Sewage lagoon 9 Feedyard 10 Livestock pens 11 Fuel storage 12 Fertilizer storage 13 Insecticide storage 14 Abandoned water well 15 Oil well/Gas well 16 Other (specify below) Unknown

Direction from well? How many feet? 0

Table with columns: FROM, TO, LITHOLOGIC LOG, FROM, TO, PLUGGING INTERVALS. Rows include: 0-10 Clay, Brown; 10-27 Clay, Light Brown to Light Red Brown; 27-45 Clay, Red Brown; 45-55 Sand, Red Brown; 55-74 Sand, Brown - Red Brown. Also includes MW27, Tag #, Flushmount; Project Name: AG -W - Manter; GeoCore # 592, #

7 CONTRACTOR'S OR LANDOWNER'S CERTIFICATION: This water well was (1) constructed, (2) reconstructed, or (3) plugged under my jurisdiction and was completed on (mo/day/year) 7/13/98 and this record is true to the best of my knowledge and belief. Kansas Water Well Contractor's License No. 527 This Water Well Record was completed on (mo/day/yr) 7/31/98 under the business name of GeoCore Services, Inc. by (signature) Dale Kell