


113128

1 LOCATION OF WATER WELL: Fraction Section Number Township Number Range Number
 County: Stanton SW ¼ SW ¼ SW ¼ 14 T 29 S R 42 EW

Distance and direction from nearest town or city street address of well if located within city?
 Johnson Coop Grain, Manter, Kansas

2 WATER WELL OWNER: Johnson Coop Grain-Manter
 RR#, St. Address, Box # : South 160 Highway Board of Agriculture, Division of Water Resources
 City, State, ZIP Code : Manter, Kansas Application Number:

REVISED 3/98

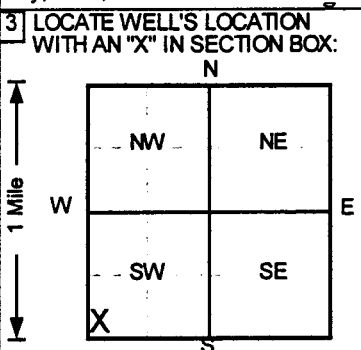

4 DEPTH OF COMPLETED WELL 70 ft ELEVATION: 0
 Depth(s) Groundwater Encountered 1 ft 2 ft 3 ft
 WELL'S STATIC WATER LEVEL ft below land surface measured on mo/day/yr
 Pump test data: Well water was NA ft after hours pumping gpm
 Est. Yield .. NA .. gpm: Well water was ft after hours pumping gpm
 Bore Hole Diameter 8 in. to 70 ft., and in. to ft.
 WELL WATER TO BE USED AS: 5 Public water supply 8 Air conditioning 11 Injection well
 1 Domestic 3 Feedlot 6 Oil field water supply 9 Dewatering 12 Other (Specify below)
 2 Irrigation 4 Industrial 7 Lawn and garden only 10 Monitoring well
 Was a chemical/bacteriological sample submitted to Department: Yes.....No✓.....; If yes, mo/day/yr sample was submitted
 Water Well Disinfected? Yes No ✓

5 TYPE OF BLANK CASING USED:
 1 Steel 3 RMP (SR) 5 Wrought iron 8 Concrete tile CASING JOINTS: Glued Clamped
 2 PVC 4 ABS 6 Asbestos-Cement 9 Other (specify below) Welded
 7 Fiberglass Threaded ✓
 Blank casing diameter 2 in. to 55 ft., Dia in. to ft., Dia in. to ft.
 Casing height above land surface 0 in., weight Sch 40 lbs./ft. Wall thickness or gauge No.
 TYPE OF SCREEN OR PERFORATION MATERIAL 7 PVC 10 Asbestos-cement
 1 Steel 3 Stainless steel 5 Fiberglass 8 RMP (SR) 11 Other (specify)
 2 Brass 4 Galvanized steel 6 Concrete tile 9 ABS 12 None used (open hole)
 SCREEN OR PERFORATION OPENINGS ARE:
 1 Continuous slot 3 Mill slot 5 Gauzed wrapped 8 Saw cut 11 None (open hole)
 2 Louvered shutter 4 Key punched 6 Wire wrapped 9 Drilled holes
 7 Torch cut 10 Other (specify)
 SCREEN-PERFORATED INTERVALS: From 55 ft to 70 ft, From ft to ft
 From ft to ft, From ft to ft
 GRAVEL PACK INTERVALS: From 53 ft to 70 ft, From ft to ft
 From ft to ft, From ft to ft

6 GROUT MATERIAL: 1 Neat cement 2 Cement grout 3 Bentonite 4 Other
 Grout Intervals: From 0 ft to 50 ft, From 50 ft to 53 ft, From ft to ft
 What is the nearest source of possible contamination:
 1 Septic tank 4 Lateral lines 7 Pit privy 10 Livestock pens 14 Abandoned water well
 2 Sewer lines 5 Cess pool 8 Sewage lagoon 11 Fuel storage 15 Oil well/Gas well
 3 Watertight sewer lines 6 Seepage pit 9 Feedyard 12 Fertilizer storage 16 Other (specify below)
 13 Insecticide storage Unknown
 Direction from well? How many feet? 0

FROM	TO	LITHOLOGIC LOG	FROM	TO	PLUGGING INTERVALS
0	15	Sand,			
15	42	Clay, Red Brown			
42	70	Sand, Red Brown			
					SVE7, Tag # , Flushmount
					Project Name: AG -W - Manter
					GeoCore # 592 , #

7 CONTRACTOR'S OR LANDOWNER'S CERTIFICATION: This water well was (1) constructed, (2) reconstructed, or (3) plugged under my jurisdiction and was completed on (mo/day/year) 12/4/97 and this record is true to the best of my knowledge and belief.
 Kansas Water Well Contractor's License No. 527 This Water Well Record was completed on (mo/day/yr) 12/30/97
 under the business name of GeoCore Services, Inc. by (signature)