


WATER WELL RECORD Form WWC-5 KSA 82a-1212

1 LOCATION OF WATER WELL: Fraction Section Number Township Number Range Number
 COUNTY: STANTION NW 1/4 SE 1/4 NW 1/4 18 T 29 S R 42 W

Distance and direction from nearest town or city street address of well if located within city?
 FROM MANTER - 3 MILES WEST, 1/2 MILE NORTH & 1/2 MILE WEST

2 WATER WELL OWNER: WILKERSON, TUBE
 RR#, St. Address, Box #: 317 E. 5TH AVE. Board of Agriculture, Division of Water Resources
 City, State, ZIP code: MANTER, KS 67862- Application Number:

3 LOCATE WELL'S LOCATION WITH AN 'X' IN SECTION BOX:

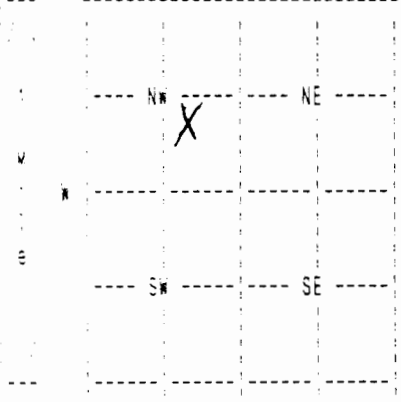

4 DEPTH OF COMPLETED WELL 225 ELEVATION: 0
 Depth(s) Groundwater Encountered 1. 0 ft. 2. 0 ft. 3. 0 ft.
 WELL'S STATIC WATER LEVEL 50 ft. below land surface measured on mo/day/yr 06/06/08
 Pump test data: Well water was 0 ft. after 0 hours pumping 0 gpm
 Estimated Yield 20 gpm: Well water was 0 ft. after 0 hours pumping 0 gpm
 Bore Hole Diameter 10 in. to 225 ft., and in. to 0 ft.
 WELL WATER TO BE USED AS: DOMESTIC
 Was a chemical/bacteriological sample submitted to department? No ;
 If yes, mo/day/yr sample was submitted Water well disinfected? Yes

5 TYPE OF BLANK CASING USED: CERTA LOC CASIN CASING JOINTS: CERTA-LOC
 Blank casing diameter 5 in. to 225 ft., Dia in. to 0 ft., Dia in. to 0 ft.
 Casing height above land surface 12 in., weight 200 lbs/ft. Wall thickness or gauge No. 21
 TYPE OF SCREEN OR PERFORATION MATERIAL: PVC
 SCREEN OR PERFORATION OPENINGS ARE: SAW CUT

SCREEN PERFORATED INTERVALS: From 160 ft. to 220 ft., From 0 ft. to 0 ft.
 From 0 ft. to 0 ft., From 0 ft. to 0 ft.
 GRAVEL PACK INTERVALS: From 20 ft. to 225 ft., From 0 ft. to 0 ft.
 From 0 ft. to 0 ft., From 0 ft. to 0 ft.

6 GROUT MATERIAL BENTONITE
 Grout intervals: From 0 ft. to 20 ft., From 0 ft. to 0 ft., From 0 ft. to 0 ft.
 What is the nearest source of possible contamination: NONE
 Direction from well? How many feet? 0

FROM	TO	LITHOLOGIC LOG	FROM	TO	PLUGGING INTERVALS
0	20	01 TOPSOIL 32 TAN CLAY 27 ROCK			
20	40	27 ROCK 16 GRAY CLAY 36 BLUE CLAY			
40	60	16 GRAY CLAY 29 SANDSTONE			
60	80	29 SANDSTONE 16 GRAY CLAY 32 TAN CLAY			
80	100	32 TAN CLAY			
100	120	32 TAN CLAY 29 SANDSTONE			
120	140	29 SANDSTONE 16 GRAY CLAY 27 ROCK			
140	160	27 ROCK 16 GRAY CLAY 29 SANDSTONE			
160	180	29 SANDSTONE			
180	220	28 SAND			

CONTRACTOR'S OR LANDOWNER'S CERTIFICATION: This water well was Constructed under my jurisdiction and was completed on (mo/day/year) 06/07/08 and this record is true to the best of my knowledge and belief. Kansas water well Contractor's License No. 179 This Water Well Record was completed on (mo/day/yr) 07/07/08 under the business name of JOE'S WELL SERVICE, INC. by (signature) *Justin Crick*