


USE TYPEWRITER OR BALL POINT PEN-PRESS FIRMLY, PRINT CLEARLY.

WATER WELL RECORD  
KSA 82a-1201-1215

Kansas Department of Health and Environment-Division of Environment  
(Water well Contractors)  
Topeka, Kansas 66620

1. Location of well:	County <b>Stanton</b>	Fraction <b>SW 1/4 1/4 1/4</b>	Section number <b>14</b>	Township number <b>T 29 S R 42</b>	Range number <b>R 42</b>
----------------------	--------------------------	-----------------------------------	-----------------------------	---------------------------------------	-----------------------------

2. Distance and direction from nearest town or city: <b>In Manter</b>	3. Owner of well: <b>City of Manter</b>
Street address of well location if in city:	R.R. or street: <b>Manter, Kansas</b>
	City, state, zip code: <b>Well No. 1</b>

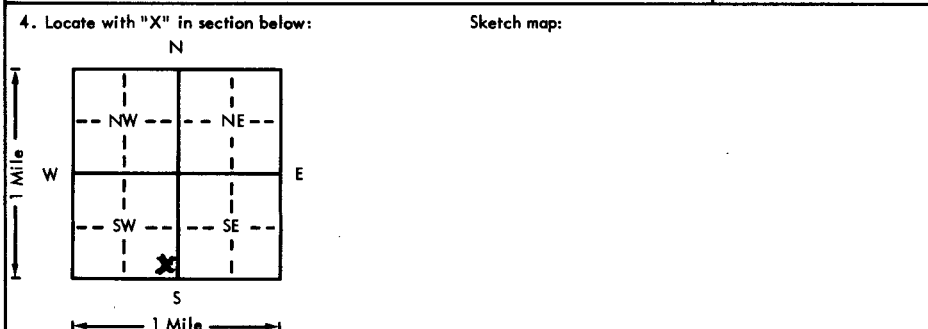

6. Bore hole dia. **30** in. Completion date **9/12/75**  
Well depth **603** ft.

7. Cable tool  Rotary  Driven  Dug  
 Hollow rod  Jetted  Bored  Reverse rotary

8. Use:  Domestic  Public supply  Industry  
 Irrigation  Air conditioning  Stock  
 Lawn  Oil field water  Other

9. Casing: Material **Stl** Height: Above ~~surface~~  
Threaded  Welded  Surface **36** in.  
RMP  PVC  Weight **4.5** lbs./ft.  
Dia. **12** in. to **303** ft. depth Wall thickness: inches or  
Dia.  in. to  ft. depth gage No. **330**

5. Type and color of material	From	To
Top soil	0	3
Tan clay caliche-yellow chalk & sandstne	3	150
Light blue clay	150	190
Sandy grey clay	190	220
Grey clay	220	248
Very fine to fine sand	248	292
Blue clay	292	352
Blue clay - fine sand streaks	352	380
Very fine to fine sand	380	406
Tan clay	406	412
Fine to coarse sand	412	420
Lt. brn sandstone-sandy red clay lenses	420	512
Red clay	512	520
Lt. brn. sandstone-lots of red clay	520	600
(Use a second sheet if needed)		

10. Screen: Manufacturer's name **Doerr**  
**Metal Products**

Type **Armco Iron** Dia. **12"**  
Slot/gauze **1/16"** Length **300'**  
Set between **253** ft. and **603** ft.  
Gravel pack?  Size range of material **1/3-2/8"**

11. Static water level:  mo./day/yr.  
**236** ft. below land surface Date **9/12/75**

12. Pumping level below land surfaces:  
**290** ft. after **7** hrs. pumping **320** g.p.m.  
\_\_\_\_\_ ft. after \_\_\_\_\_ hrs. pumping \_\_\_\_\_ g.p.m.  
Estimated maximum yield **300** g.p.m.

13. Water sample submitted:  mo./day/yr.  
Yes  No  Date \_\_\_\_\_

14. Well head completion:  
 Pitless adapter **30** inches above grade

15. Well grouted? **yes**  
With:  Neat cement  Bentonite  Concrete  
Depth: From **0** ft. to **20** ft.

16. Nearest source of possible contamination: **City Sewer Lines**  
ft. **100'** Direction \_\_\_\_\_ Type \_\_\_\_\_  
Well disinfected upon completion?  Yes  No

17. Pump:  Not installed  
Manufacturer's name **Layne**  
Model number **BRK** HP **50** Volts **230/110**  
Length of drop pipe **400** ft. capacity **300** g.p.m.  
Type:  
 Submersible  Turbine  
 Jet  Reciprocating  
 Centrifugal  Other

18. Elevation:	19. Remarks:
Topography: <input type="checkbox"/> Hill <input checked="" type="checkbox"/> Slope <input checked="" type="checkbox"/> Upland <input type="checkbox"/> Valley	

20. Water well contractor's certification:  
This well was drilled under my jurisdiction and this report is true to the best of my knowledge and belief.

**Layne Western Co.** 102  
Business name License No.  
Address **Wichita, Kansas**  
Signed **[Signature]** Date **10/1/74**  
Authorized representative

T 29  
 R 42  
 S  
 W  
 Sec 14  
 SE 1/4 SW 1/4