


1) LOCATION OF WATER WELL: Fraction X X/S2/S2 X Section Number 35 Township Number T 29 (S) Range Number R 42 E (W)

Distance and direction from nearest town or city street address of well if located within city?
 3 miles South, .5 mile East of Mantor, Kansas

2) WATER WELL OWNER: DAVE BOZONE
 RR#, St. Address, Box # : HC-02 Board of Agriculture, Division of Water Resources
 City, State, ZIP Code : ROLLA, KS 67954 Application Number:

3) LOCATE WELL'S LOCATION WITH AN "X" IN SECTION BOX:

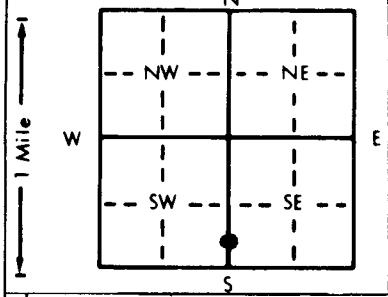

4) DEPTH OF COMPLETED WELL: 220 ft. ELEVATION:
 Depth(s) Groundwater Encountered 1. 180 ft. 2. ft. 3. ft.
 WELL'S STATIC WATER LEVEL . 180 ft. below land surface measured on mo/day/yr . 8-3-94
 Pump test data: Well water was . 200 ft. after . 1 hours pumping . 60 gpm
 Est. Yield . 60 gpm: Well water was . ft. after . hours pumping . gpm
 Bore Hole Diameter . 9 1/2 in. to . 220 ft., and . in. to . ft.
 WELL WATER TO BE USED AS: 5 Public water supply 8 Air conditioning 11 Injection well
 1 Domestic 3 Feedlot 6 Oil field water supply 9 Dewatering 12 Other (Specify below)
 2 Irrigation 4 Industrial 7 Lawn and garden only 10 Monitoring well
 Was a chemical/bacteriological sample submitted to Department? Yes. No. X; If yes, mo/day/yr sample was sub-
 mitted Water Well Disinfected? Yes X No

5) TYPE OF BLANK CASING USED: 5 Wrought iron 8 Concrete tile CASING JOINTS: Glued X Clamped
 1 Steel 3 RMP (SR) 6 Asbestos-Cement 9 Other (specify below) Welded
 2 PVC 4 ABS 7 Fiberglass Threaded

Blank casing diameter . 5 in. to . 220 ft., Dia . in. to . ft., Dia . in. to . ft.
 Casing height above land surface . 24 in., weight . 2.902 lbs./ft. Wall thickness or gauge No. . 265 SDR 21

TYPE OF SCREEN OR PERFORATION MATERIAL: 7 PVC 10 Asbestos-cement
 1 Steel 3 Stainless steel 5 Fiberglass 8 RMP (SR) 11 Other (specify)
 2 Brass 4 Galvanized steel 6 Concrete tile 9 ABS 12 None used (open hole)

SCREEN OR PERFORATION OPENINGS ARE: 5 Gauzed wrapped 8 Saw cut 11 None (open hole)
 1 Continuous slot 3 Mill slot 6 Wire wrapped 9 Drilled holes
 2 Louvered shutter 4 Key punched 7 Torch cut 10 Other (specify)

SCREEN-PERFORATED INTERVALS: From . 120 ft. to . 220 ft., From . ft. to . ft.
 From . ft. to . ft., From . ft. to . ft.
 GRAVEL PACK INTERVALS: From . 43 ft. to . 220 ft., From . ft. to . ft.
 From . ft. to . ft., From . ft. to . ft.

6) GROUT MATERIAL: 1 Neat cement 2 Cement grout 3 Bentonite 4 Other HOLE PLUG
 Grout Intervals: From . 1 ft. to . 20 ft., From . ft. to . ft., From . ft. to . ft.

What is the nearest source of possible contamination:
 1 Septic tank 4 Lateral lines 7 Pit privy 10 Livestock pens 14 Abandoned water well
 2 Sewer lines 5 Cess pool 8 Sewage lagoon 11 Fuel storage 15 Oil well/Gas well
 3 Watertight sewer lines 6 Seepage pit 9 Feedyard 12 Fertilizer storage 16 Other (specify below)
 13 Insecticide storage

Direction from well? How many feet?

FROM	TO	LITHOLOGIC LOG	FROM	TO	PLUGGING INTERVALS
0	6	TOP SOIL			
6	30	CLAY			
30	54	CLAY W/STREAKS OF SAND STONE			
54	63	SANDY CLAY			
63	71	SAND			
71	74	SAND W/YELLOW SAND STREAKS			
74	78	SAND STONE W/RED & BLUE CLAY			
78	94	YELLOW & FINE SAND			
94	110	SMALL GRAVEL W/BLUE CLAY STREAKS			
110	137	SAND STONE W/BLUE & YELLOW STREAKS			
137	215	WHITE FINE SAND			
215	220	BLUE CLAY W/SAND			

7) CONTRACTOR'S OR LANDOWNER'S CERTIFICATION: This water well was (1) constructed, (2) reconstructed, or (3) plugged under my jurisdiction and was completed on (mo/day/year) . 8-3-94 . and this record is true to the best of my knowledge and belief. Kansas Water Well Contractor's License No. . KWWCL-430 . This Water Well Record was completed on (mo/day/yr) . 8-3-94 . under the business name of HOWARD DRLG.CO.BOX 806 BEAVR, OK 73932 by (signature) *Howard Drlg*