


1 LOCATION OF WATER WELL: COUNTY: STANTION Fraction SE 1/4 SE 1/4 NE 1/4 Section Number 22 Township Number T 29 S Range Number R 43 *SW*

Distance and direction from nearest town or city street address of well if located within city?
FROM HANTER - 3 1/2 W ON 160 - 3W ON 17 & 58 - 1/2 ON 13X

2 WATER WELL OWNER: MAIRN, ARCH RR#, St. Address, Box #: P.O. BOX 486 City, State, ZIP code : JOHNSON CITY, KS 67855- Board of Agriculture, Division of Water Resources Application Number:

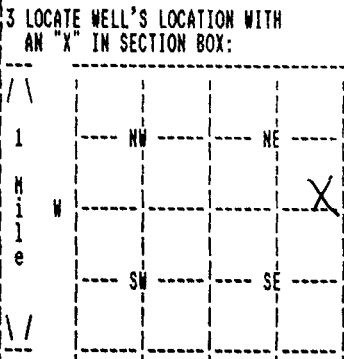

4 DEPTH OF COMPLETED WELL 325 ELEVATION: 0
Depth(s) Groundwater Encountered 1. 0 ft. 2. 0 ft. 3. 0 ft.
WELL'S STATIC WATER LEVEL 100 ft. below land surface measured on mo/day/yr 09/16/96
Pump testdata: Well water was 0 ft. after 0 hours pumping 0 gpm
Estimated Yield 12 gpm: Well water was 0 ft. after 0 hours pumping 0 gpm
Bore Hole Diameter 10 in. to 325 ft., and in. to 0 ft.
WELL WATER TO BE USED AS: DOMESTIC
Was a chemical/bacteriological sample submitted to department? No ;
If yes, mo/day/yr sample was submitted Water well disinfected? Yes

5 TYPE OF BLANK CASING USED: PVC CASING JOINTS: GLUED
Blank casing diameter 5 in. to 325 ft., Dia in. to 0 ft., Dia in. to 0 ft.
Casing height above land surface 12 in., weight 200 lbs/ft. Wall thickness or gauge No. 21 17
TYPE OF SCREEN OR PERFORATION MATERIAL: PVC
SCREEN OR PERFORATION OPENINGS ARE: SAW CUT

SCREEN PERFORATED INTERVALS: From 180 ft. to 200 ft., From 0 ft. to 0 ft.
From 300 ft. to 320 ft., From 0 ft. to 0 ft.
GRAVEL PACK INTERVALS: From 25 ft. to 268 ft., From 0 ft. to 0 ft.
From 273 ft. to 325 ft., From 0 ft. to 0 ft.

6 GROUT MATERIAL BENTONITE
Grout Intervals: From 0 ft. to 25 ft., From 268 ft. to 273 ft., From 0 ft. to 0 ft.
What is the nearest source of possible contamination: ABANDONED WELL
Direction from well? SOUTHEAST How many feet? 50

FROM	TO	LITHOLOGIC LOG	FROM	TO	PLUGGING INTERVALS
0	20	TOPSOIL CLAY FINE SAND			
20	45	FINE - MED SAND			
45	60	CLAY ROCK LAYERS			
60	110	CLAY THIN ROCK LAYER			
110	160	SANDSTONE			
160	210	SANDSTONE CLAY LAYERS			
210	240	BLUE SHALE ROCK LAYERS			
240	330	SANDSTONE			

7 CONTRACTOR'S OR LANDOWNER'S CERTIFICATION: This water well was constructed under my jurisdiction and was completed on (mo/day/year) 09/17/96 and this record is true to the best of my knowledge and belief. Kansas Water Well Contractor's License No. 179 This Water Well Record was completed on (mo/day/yr) 10/31/96 under the business name of JOE'S WELL SERVICE, INC. by (signature) *Joseph Crick*