


1 LOCATION OF WATER WELL: Fraction Section Number Township Number Range Number  
 COUNTY: STANTION NW 1/4 NW 1/4 SB 1/4 16 T 29 S R 43 W

Distance and direction from nearest town or city street address of well if located within city?  
 FROM HANTER - 3 NORTH, 6 WEST, 3 SOUTH, 1/2 WEST & 1/2 SOUTH

2 WATER WELL OWNER: BEARCE, VERNON  
 RR#, St. Address, Box #: BOX 597 Board of Agriculture, Division of Water Resources  
 City, State, ZIP code: JOHNSON, KS 67855- Application Number:

3 LOCATE WELL'S LOCATION WITH AN "X" IN SECTION BOX: 4 DEPTH OF COMPLETED WELL 62 ELEVATION: 0  
 Depth(s) Groundwater Encountered 1. 0 ft. 2. 0 ft. 3. 0 ft.

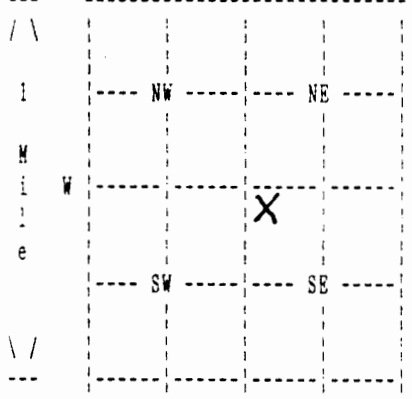

WELL'S STATIC WATER LEVEL 40 ft. below land surface measured on mo/day/yr 07/27/05  
 Pump testdata: Well water was 0 ft. after 0 hours pumping 0 gpm  
 Estimated Yield 15 gpm: Well water was 0 ft. after 0 hours pumping 0 gpm  
 Bore Hole Diameter 10 in. to 62 ft., and in. to 0 ft.  
 WELL WATER TO BE USED AS: DOMESTIC  
 Was a chemical/bacteriological sample submitted to department? No ;  
 If yes, mo/day/yr sample was submitted Water well disinfected? Yes

5 TYPE OF BLANK CASING USED: PVC CASING JOINTS: GLUED  
 Blank casing diameter 5 in. to 62 ft., Dia in. to 0 ft., Dia in. to 0 ft.  
 Casing height above land surface 12 in., weight 200 lbs/ft. Wall thickness or gauge No. 21  
 TYPE OF SCREEN OR PERFORATION MATERIAL: PVC  
 SCREEN OR PERFORATION OPENINGS ARE: SAW CUT

SCREEN PERFORATED INTERVALS: From 40 ft. to 60 ft., From 0 ft. to 0 ft.  
 From 0 ft. to 0 ft., From 0 ft. to 0 ft.  
 GRAVEL PACK INTERVALS: From 25 ft. to 62 ft., From 0 ft. to 0 ft.  
 From 0 ft. to 0 ft., From 0 ft. to 0 ft.

6 GROUT MATERIAL BENTONITE  
 Grout Intervals: From 5 ft. to 25 ft., From 0 ft. to 0 ft., From 0 ft. to 0 ft.  
 What is the nearest source of possible contamination: ABANDONED WELL  
 Direction from well? EAST How many feet? 45

FROM	TO	LITHOLOGIC LOG	FROM	TO	PLUGGING INTERVALS
0	20	01 TOPSOIL 05 CLAY 24 THINROCLAYER			
20	40	37 FIN-COAR SAN 24 THINROCLAYER			
40	58	37 FIN-COAR SAN 24 THINROCLAYER 38 SMAL-MED G			
58	80	32 TAN CLAY 16 GRAY CLAY 36 BLUE CLAY			

7 CONTRACTOR'S OR LANDOWNER'S CERTIFICATION: This water well was Constructed under my jurisdiction and was completed on (mo/day/year) 07/27/05 and this record is true to the best of my knowledge and belief. Kansas Water Well Contractor's License No. 179 This Water Well Record was completed on (mo/day/yr) 07/29/05 under the business name of JOB'S WELL SERVICE, INC. by (signature) *Jusid Creek*