


WATER WELL RECORD Form WWC-5 KSA 82a-1212

1 LOCATION OF WATER WELL: Fraction Section Number Township Number Range Number
 COUNTY: STANTION SE 1/4 SE 1/4 SW 1/4 10 T 29 S R 43 W

Distance and direction from nearest town or city street address of well if located within city?
 FROM MANTER - 4N ON MANTER GRADE RD. W TO RD X 13SW 3S & 1W

2 WATER WELL OWNER: BEARCE, DEAN Board of Agriculture, Division of Water Resources
 RR#, St. Address, Box #: 2330 S. ROAD X Application Number:
 City, State, ZIP code: MANTER, KS 67862-

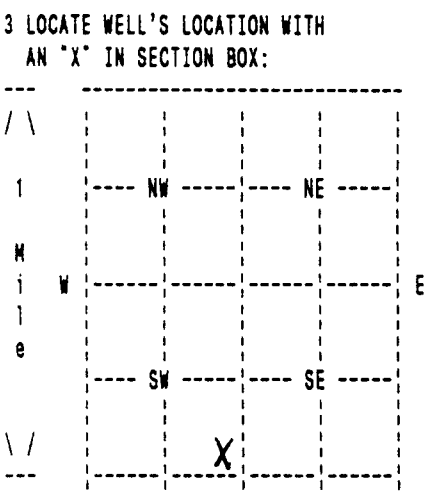

4 DEPTH OF COMPLETED WELL 220 ELEVATION: 0
 Depth(s) Groundwater Encountered 1. 0 ft. 2. 0 ft. 3. 0 ft.
 WELL'S STATIC WATER LEVEL 180 ft. below land surface measured on mo/day/yr 09/12/07
 Pump test data: Well water was 0 ft. after 0 hours pumping 0 gpm
 Estimated Yield 5 gpm: Well water was 0 ft. after 0 hours pumping 0 gpm
 Bore Hole Diameter 9 in. to 220 ft., and in. to 0 ft.
 WELL WATER TO BE USED AS: DOMESTIC
 Was a chemical/bacteriological sample submitted to department? No ;
 If yes, mo/day/yr sample was submitted Water well disinfected? Yes

5 TYPE OF BLANK CASING USED: CERTA LOC CASIN CASING JOINTS: CERTA-LOC
 Blank casing diameter 5 in. to 220 ft., Dia in. to 0 ft., Dia in. to 0 ft.
 Casing height above land surface 12 in., weight 200 lbs/ft. Wall thickness or gauge No. 21
 TYPE OF SCREEN OR PERFORATION MATERIAL: PVC
 SCREEN OR PERFORATION OPENINGS ARE: SAW CUT

SCREEN PERFORATED INTERVALS: From 100 ft. to 120 ft., From 0 ft. to 0 ft.
 From 180 ft. to 220 ft., From 0 ft. to 0 ft.
 GRAVEL PACK INTERVALS: From 20 ft. to 220 ft., From 0 ft. to 0 ft.
 From 0 ft. to 0 ft., From 0 ft. to 0 ft.

6 GROUT MATERIAL BENTONITE
 Grout Intervals: From 0 ft. to 20 ft., From 0 ft. to 0 ft., From 0 ft. to 0 ft.
 What is the nearest source of possible contamination: ABANDONED WELL
 Direction from well? NORTHEAST How many feet? 25

FROM	TO	LITHOLOGIC LOG	FROM	TO	PLUGGING INTERVALS
0	20	01 TOPSOIL 32 TAN CLAY 10 FINE-MEDSAND			
20	40	32 TAN CLAY 08 ROCK LAYERS			
40	60	32 TAN CLAY 16 GRAY CLAY 08 ROCK LAYERS			
60	80	16 GRAY CLAY BROWN 08 ROCK LAYERS			
80	100	16 GRAY CLAY 40 TAN SANDSTON			
100	120	16 GRAY CLAY 26 RED CLAY 40 TAN SANDSTON			
120	140	40 TAN SANDSTON 32 TAN CLAY 19 LAYERS			
140	160	39 SAND ROCK 16 GRAY CLAY			
160	180	16 GRAY CLAY 26 RED CLAY 29 SANDSTONE			
180	220	29 SANDSTONE			

7 CONTRACTOR'S OR LANDOWNER'S CERTIFICATION: This water well was Constructed under my jurisdiction and was completed on (mo/day/year) 09/12/07 and this record is true to the best of my knowledge and belief. Kansas Water Well Contractor's License No. 179 This Water Well Record was completed on (mo/day/yr) 09/19/07 under the business name of JOE'S WELL SERVICE, INC. by (signature) *Insid creek*