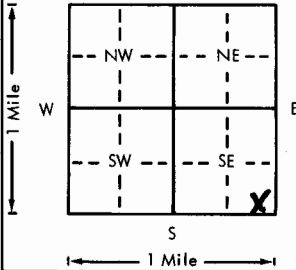
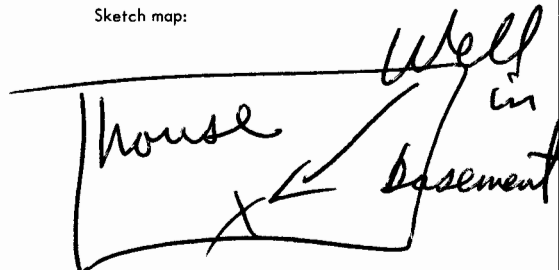


USE TYPEWRITER OR BALL  
POINT PEN-PRESS FIRMLY,  
PRINT CLEARLY.

WATER WELL RECORD  
KSA 82a-1201-1215

Kansas Department of Health and  
Environment-Division of Environment  
(Water well Contractors)  
Topeka, Kansas 66620

1. Location of well:		County <b>Kingman</b>	Fraction <b>SE 1/4 SE 1/4 SE 1/4</b>	Section number <b>10</b>	Township number <b>T 29 S R 5 E W</b>	Range number <b>5</b>
2. Distance and direction from nearest town or city: <b>7 miles N.W. Norwich KS</b>				3. Owner of well: <b>Dave Jump</b> R.R. or street: <b>Box 341</b> City, state, zip code: <b>Cheney KS 67025</b>		
4. Locate with "X" in section below:		Sketch map:		6. Bore hole dia. <b>11</b> in. Completion date Well depth <b>65</b> ft. <b>3/20/78</b>		
				7. <input type="checkbox"/> Cable tool <input checked="" type="checkbox"/> Rotary <input type="checkbox"/> Driven <input type="checkbox"/> Dug <input type="checkbox"/> Hollow rod <input checked="" type="checkbox"/> Jetted <input type="checkbox"/> Bored <input type="checkbox"/> Reverse rotary		
5. Type and color of material				From	To	8. Use: <input checked="" type="checkbox"/> Domestic <input type="checkbox"/> Public supply <input type="checkbox"/> Industry <input type="checkbox"/> Irrigation <input type="checkbox"/> Air conditioning <input type="checkbox"/> Stock <input type="checkbox"/> Lawn <input type="checkbox"/> Oil field water <input type="checkbox"/> Other
Top soil				0	4	9. Casing: Material <b>PC</b> Height <b>Above</b> or below
med gravel				4	20	Threaded <input type="checkbox"/> Welded <input checked="" type="checkbox"/> Surface <b>12</b> in.
blue-green shale				20	24	RMP <input type="checkbox"/> PVC <input checked="" type="checkbox"/> Weight <b>276</b> lbs./ft.
red shale				24	51	Dia. <b>5</b> in. to <b>65</b> ft. depth Wall Thickness: inches or
blue-green shale				51	52	Dia. <b>5</b> in. to <b>65</b> ft. depth gage No. <b>1258</b>
Red shale				52	65	10. Screen: Manufacturer's name <b>MPI</b>
						Type <b>Sch 40</b> Dia. <b>5</b> in.
						Slot gauge <b>1 1/16</b> Length <b>20 ft</b>
						Set between <b>45</b> ft. and <b>56</b> ft.
						Gravel pack <b>yes</b> Size range of material <b>38</b>
						11. Static water level: <b>33</b> ft. below land surface Date <b>3/20/78</b>
						12. Pumping level below land surfaces:
						<b>35</b> ft. after <b>12</b> hrs. pumping <b>15</b> g.p.m.
						<b>35</b> ft. after <b>12</b> hrs. pumping <b>15</b> g.p.m.
						Estimated maximum yield <b>30</b> g.p.m.
						13. Water sample submitted: <b>mo./day/yr.</b>
						<input type="checkbox"/> Yes <input checked="" type="checkbox"/> No Date
						14. Well head completion:
						<input type="checkbox"/> Pitless adapter <b>12</b> inches above grade
						15. Well grouted? <b>yes</b>
						With: <input type="checkbox"/> Neat cement <input type="checkbox"/> Bentonite <input checked="" type="checkbox"/> Concrete
						Depth: From <b>12</b> ft. to <b>16</b> ft.
						16. Nearest source of possible contamination:
						ft. <b>None</b> Direction <b>None</b>
						Well disinfected upon completion? <input checked="" type="checkbox"/> Yes <input type="checkbox"/> No
						17. Pump: <input checked="" type="checkbox"/> Not installed
						Manufacturer's name
						Model number <b>HP</b> <b>Volts</b>
						Length of drop pipe <b>ft.</b> capacity <b>g.p.m.</b>
						Type:
						<input type="checkbox"/> Submersible <input type="checkbox"/> Turbine
						<input type="checkbox"/> Jet <input type="checkbox"/> Reciprocating
						<input type="checkbox"/> Centrifugal <input type="checkbox"/> Other
18. Elevation:		19. Remarks:		20. Water well contractor's certification:		
Topography:				This well was drilled under my jurisdiction and this report is true to the best of my knowledge and belief.		
<input checked="" type="checkbox"/> Hill				Business name <b>Wm. H. Bulley</b> License No. <b>318</b>		
<input type="checkbox"/> Slope				Address <b>Cheney</b>		
<input type="checkbox"/> Upland				Sign <b>J. R. Eminger</b> Date <b>3/21/78</b>		
<input type="checkbox"/> Valley				Authorized representative		