

1 LOCATION OF WATER WELL:	Fraction	Section Number	Township Number	Range Number
County: <u>Kingman</u>	<u>SW 1/4 NE 1/4 NE 1/4</u>	<u>10</u>	T <u>29</u> S	R <u>5</u> EW

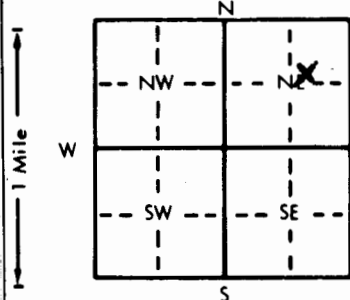
Distance and direction from nearest town or city street address of well if located within city?

3 West 5 1/4 So Cheney Ks.

2 WATER WELL OWNER:	Board of Agriculture, Division of Water Resources
RR#, St. Address, Box # :	Application Number:
City, State, ZIP Code :	

Clarence RauRRNoewich Ks.

3 LOCATE WELL'S LOCATION WITH AN "X" IN SECTION BOX:	4 DEPTH OF COMPLETED WELL: . . . . . ft. ELEVATION: . . . . . ft.
--	---

Depth(s) Groundwater Encountered 1. 30 ft. 2. . . . . ft. 3. . . . . ft.WELL'S STATIC WATER LEVEL 30 ft. below land surface measured on mo/day/yr 9-10-81Pump test data: Well water was 55 ft. after 12 hours pumping 6 gpmEst. Yield 6-7 gpm: Well water was . . . . . ft. after . . . . . hours pumping . . . . . gpmBore Hole Diameter: 11 in. to 65 ft., and . . . . . in. to . . . . . ft.

WELL WATER TO BE USED AS:

5 Public water supply	8 Air conditioning	11 Injection well
1 Domestic	3 Feedlot	6 Oil field water supply
2 Irrigation	4 Industrial	7 Lawn and garden only
		10 Observation well

Was a chemical/bacteriological sample submitted to Department? Yes . . . . . No . . . . .; If yes, mo/day/yr sample was submitted

Water Well Disinfected? Yes X No

5 TYPE OF BLANK CASING USED:	5 Wrought iron	8 Concrete tile	CASING JOINTS: <u>Glued</u> <u>X</u> Clamped
1 Steel	3 RMP (SR)	6 Asbestos-Cement	9 Other (specify below)
2 PVC	4 ABS	7 Fiberglass	Welded . . . . .
			Threaded . . . . .

Blank casing diameter 5 in. to 18 ft., Dia. . . . . in. to . . . . . ft., Dia. . . . . in. to . . . . . ft.Casing height above land surface 12 in., weight 1.59 lbs./ft. Wall thickness or gauge No. SDC-26

TYPE OF SCREEN OR PERFORATION MATERIAL:	7 PVC	10 Asbestos-cement
1 Steel	3 Stainless steel	5 Fiberglass
2 Brass	4 Galvanized steel	6 Concrete tile
		8 RMP (SR)
		9 ABS
		11 Other (specify)
		12 None used (open hole)

SCREEN OR PERFORATION OPENINGS ARE:

1 Continuous slot	3 Mill slot	5 Gauzed wrapped	8 Saw cut	11 None (open hole)
2 Louvered shutter	4 Key punched	6 Wire wrapped	9 Drilled holes	
		7 Torch cut	10 Other (specify)	

SCREEN-PERFORATED INTERVALS: From 18 ft. to 65 ft., From . . . . . ft. to . . . . . ft.

From . . . . . ft. to . . . . . ft., From . . . . . ft. to . . . . . ft.

GRAVEL PACK INTERVALS: From 13 ft. to 65 ft., From . . . . . ft. to . . . . . ft.

From . . . . . ft. to . . . . . ft., From . . . . . ft. to . . . . . ft.

From . . . . . ft. to . . . . . ft., From . . . . . ft. to . . . . . ft.

7 CONTRACTOR'S OR LANDOWNER'S CERTIFICATION: This water well was (1) constructed, (2) reconstructed, or (3) plugged under my jurisdiction and was completed on (mo/day/year) <u>9-10-81</u> and this record is true to the best of my knowledge and belief. Kansas
--

Water Well Contractor's License No. 318 This Water Well Record was completed on (mo/day/yr) 11-10-81under the business name of Weninger Pully by (signature) James Weninger

INSTRUCTIONS: Use typewriter or ball point pen, PLEASE PRESS FIRMLY and PRINT clearly. Please fill in blanks, underline or circle the correct answers. Send top

three copies to Kansas Department of Health and Environment, Division of Environment, Environmental Geology Section, Topeka, KS 66620. Send one to WATER WELL

OWNER and retain one for your records.