


1 LOCATION OF WATER WELL: County: Kingman Fraction: NW 1/4 SE 1/4 SW 1/4 Section Number: 30 Township Number: T 29 S Range Number: R 5 E W

Distance and direction from nearest town or city street address of well if located within city?

3 E 2 No. Adams Ks.

2 WATER WELL OWNER: DUKE DRILLING  
RR#, St. Address, Box #: 630 Hubbard PO 823  
City, State, ZIP Code: Greathorn Ks. 67530  
Board of Agriculture, Division of Water Resources  
Application Number:

3 LOCATE WELL'S LOCATION WITH AN "X" IN SECTION BOX:

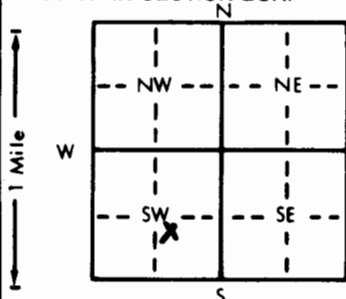

4 DEPTH OF COMPLETED WELL: 60 ft. ELEVATION:

Depth(s) Groundwater Encountered 1. 23 ft. 2. 23 ft. 3. 23 ft.

WELL'S STATIC WATER LEVEL 23 ft. below land surface measured on 11-23-88 mo/day/yr

Pump test data: Well water was 23 ft. after 2 hours pumping 20 gpm

Est. Yield 50 gpm: Well water was 23 ft. after 2 hours pumping 20 gpm

Bore Hole Diameter 11 in. to 60 ft., and 60 in. to 60 ft.

WELL WATER TO BE USED AS: 5 Public water supply 8 Air conditioning 11 Injection well

1 Domestic 3 Feedlot 6 Oil field water supply 9 Dewatering 12 Other (Specify below)

2 Irrigation 4 Industrial 7 Lawn and garden only 10 Monitoring well

Was a chemical/bacteriological sample submitted to Department? Yes X No X; If yes, mo/day/yr sample was submitted

Water Well Disinfected? Yes X No

5 TYPE OF BLANK CASING USED: 1 Steel 2 PVC 3 RMP (SR) 4 ABS 5 Wrought iron 6 Asbestos-Cement 7 Fiberglass 8 Concrete tile 9 Other (specify below) CASING JOINTS: Glued X Clamped

Blank casing diameter 5 in. to 40 ft., Dia. 40 in. to 40 ft., Dia. 40 in. to 40 ft.

Casing height above land surface 12 in., weight 1.59 lbs./ft. Wall thickness or gauge No. 50R26

TYPE OF SCREEN OR PERFORATION MATERIAL: 1 Steel 2 Brass 3 Stainless steel 4 Galvanized steel 5 Fiberglass 6 Concrete tile 7 PVC 8 RMP (SR) 9 ABS 10 Asbestos-cement 11 Other (specify) 12 None used (open hole)

SCREEN OR PERFORATION OPENINGS ARE: 1 Continuous slot 2 Louvered shutter 3 3 Mill slot 4 Key punched 5 Gauzed wrapped 6 Wire wrapped 7 Torch cut 8 Saw cut 9 Drilled holes 10 Other (specify) 11 None (open hole)

SCREEN-PERFORATED INTERVALS: From 40 ft. to 60 ft., From 40 ft. to 60 ft., From 40 ft. to 60 ft.

GRAVEL PACK INTERVALS: From 20 ft. to 60 ft., From 20 ft. to 60 ft., From 20 ft. to 60 ft.

6 GROUT MATERIAL: 1 Neat cement 2 Cement grout 3 Bentonite 4 Other

Grout Intervals: From 0 ft. to 20 ft., From 20 ft. to 60 ft., From 20 ft. to 60 ft.

What is the nearest source of possible contamination: 1 Septic tank 2 Sewer lines 3 Watertight sewer lines 4 Lateral lines 5 Cess pool 6 Seepage pit 7 Pit privy 8 Sewage lagoon 9 Feedyard 10 Livestock pens 11 Fuel storage 12 Fertilizer storage 13 Insecticide storage 14 Abandoned water well 15 Oil well/Gas well 16 Other (specify below)

Direction from well? OPEN FIELD

How many feet?

FROM TO LITHOLOGIC LOG FROM TO PLUGGING INTERVALS

0 2 Top soil

2 13 clay

13 48 med. SAND

48 60 Shale

7 CONTRACTOR'S OR LANDOWNER'S CERTIFICATION: This water well was (1) constructed, (2) reconstructed, or (3) plugged under my jurisdiction and was completed on (mo/day/year) 11-23-88 and this record is true to the best of my knowledge and belief. Kansas

Water Well Contractor's License No. 318 This Water Well Record was completed on (mo/day/yr) 11-24-88

under the business name of Weninger Drilling Inc. by (signature) [Signature]