

1 LOCATION OF WATER WELL:		Fraction	495 FNL	NEW NW	Section Number	Township Number	Range Number
County:	Kingman	1100FWL	490	1/4 NW 1/4	31	T 29 S	R 5W E(W)

Distance and direction from nearest town or city street address of well if located within city?


4 W, 2 N of Norwich, Kansas

2	WATER WELL OWNER:	Larry Stuckey	H-30 Drilling, Inc.	Stuckey 1-31
	RR#, St. Address, Box # :	Rago, Kansas	251 N. Water, Suite 10	Board of Agriculture, Division of Water Resources
	City, State, ZIP Code :	67128	Wichita, Kansas 67202	Application Number: 86-423 86-423

3 LOCATE WELL'S LOCATION WITH AN "X" IN SECTION BOX:

4 DEPTH OF COMPLETED WELL 60 ft. ELEVATION: Unknown

Depth(s) Groundwater Encountered 1.24 ft. 2. ft. 3. ft.

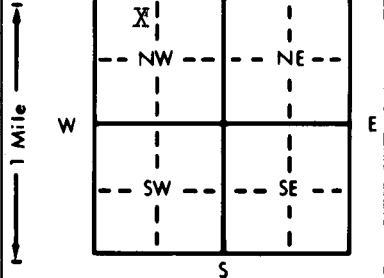

WELL'S STATIC WATER LEVEL 32 ft. below land surface measured on mo/day/yr 11/26/86.....

Pump test data: Well water was ft. after hours pumping gpm

Est. Yield 60 gpm: Well water was ft. after hours pumping gpm

Bore Hole Diameter 8 in. to 60 ft., and in. to ft.

WELL WATER TO BE USED AS:

5 Public water supply	8 Air conditioning	11 Injection well
1 Domestic	3 Feedlot	6 <u>Oil field water supply</u>
		9 Dewatering
2 Irrigation	4 Industrial	12 Other (Specify below)
	7 Lawn and garden only	10 Observation well

Was a chemical/bacteriological sample submitted to Department? Yes..... No.....; If yes, mo/day/yr sample was submitted

Water Well Disinfected? Yes No

5	TYPE OF BLANK CASING USED:	5 Wrought iron	8 Concrete tile	CASING JOINTS: <u>Glued</u> Clamped
	1 Steel	3 RMP (SR)	6 Asbestos-Cement	9 Other (specify below)
	2 <u>PVC</u>	4 ABS	7 Fiberglass	Welded
				Threaded

Blank casing diameter 5 in. to 40 ft., Dia in. to ft.
Casing height above land surface 12 in., weight 2.8 lbs./ft. Wall thickness or gauge No. Sch. 40

TYPE OF SCREEN OR PERFORATION MATERIAL:			7 <u>PVC</u>	10 Asbestos-cement
1 Steel	3 Stainless steel	5 Fiberglass	8 RMP (SR)	11 Other (specify)
2 Brass	4 Galvanized steel	6 Concrete tile	9 ABS	12 None used (open hole)

SCREEN OR PERFORATION OPENINGS ARE:		5 Gauzed wrapped	8 <u>Saw cut</u>	11 None (open hole)
1 Continuous slot	3 Mill slot	6 Wire wrapped	9 Drilled holes	
2 Louvered shutter	4 Key punched	7 Torch cut	10 Other (specify)	

SCREEN-PERFORATED INTERVALS:	From	40	ft. to	60	ft., From	ft. to	ft.
	From		ft. to		ft., From	ft. to	ft.
GRAVEL PACK INTERVALS:	From	10	ft. to	60	ft., From	ft. to	ft.
	From		ft. to		ft., From	ft. to	ft.

6 GROUT MATERIAL: 1 Neat cement 2 Cement grout 3 Bentonite 4 Other

Grout Intervals: From 0 ft. to 10 ft. From ft. to ft. From ft. to ft.

What is the nearest source of possible contamination:

1 Septic tank	4 Lateral lines	7 Pit privy	10 Livestock pens	14 Abandoned water well
2 Sewer lines	5 Cess pool	8 Sewage lagoon	11 Fuel storage	15 <u>Oil well/Gas well</u>
3 Watertight sewer lines	6 Seepage pit	9 Feedyard	12 Fertilizer storage	16 Other (specify below)
Direction from well?	South		13 Insecticide storage	
			How many feet?	60

[illegible]

7 CONTRACTOR'S OR LANDOWNER'S CERTIFICATION: This water well was (1) constructed, (2) reconstructed, or (3) plugged under my jurisdiction and was completed on (mo/day/year) 11/26/86 and this record is true to the best of my knowledge and belief. Kansas

Water Well Contractor's License No.186..... This Water Well Record was completed on (mo/day/yr)12/8/86.....
under the business name of Kelly's Water Well Service by (signature) *[Signature]*

INSTRUCTIONS: Use typewriter or ball point pen. PLEASE PRESS FIRMLY and PRINT clearly. Please fill in blanks, underline or circle the correct answers. Send top three copies to Kansas Department of Health and Environment, Office of Oil Field and Environmental Geology, Regulation and Permitting Section, Topeka, Kansas 66620-7500, Telephone: 913-862-9360. Send one to WATER WELL OWNER and retain one for your records.