

WATER WELL RECORD

Form WWC-5


Division of Water Resources App. No.

48852

1 LOCATION OF WATER WELL: County: Kingman Fraction NE 1/4 SE 1/4 NE 1/4 SW 1/4 Section Number 19 Township No. T 29 S Range Number R 5 [] E [] W

Street/Rural Address of Well Location; if unknown, distance & direction from nearest town or intersection: If at owner's address, check here []. From Murdock, Ks. 6S 1E 1/2S 1/2E 1/4S Global Positioning System (GPS) information: Latitude: 37.50735 Longitude: 097.90792 Elevation: 1491

2 WATER WELL OWNER: Kenton Rosenhaen RR#, Street Address, Box #: 12236 SE 100th Ave. City, State, ZIP Code : Norwich, Kansas 67118 Collection Method: [] GPS unit (Make/Model: Garmin 62s) [] Digital Map/Photo [] Topographic Map [] Land Survey Est. Accuracy: [] <3 m [] 3-5 m [] 5-15 m [] >15 m

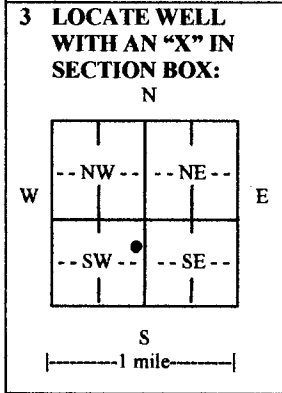

3 LOCATE WELL WITH AN 'X' IN SECTION BOX: N 4 DEPTH OF COMPLETED WELL 70 ft. Depth(s) Groundwater Encountered (1)..... ft. (2)..... ft. (3)..... ft. WELL'S STATIC WATER LEVEL 20 ft. below land surface measured on mo/day/yr. 3/17/2016 Pump test data: Well water was..... ft. after..... hours pumping..... gpm EST. YIELD..... gpm. Well water was..... ft. after..... hours pumping..... gpm Bore Hole Diameter 40 in. to 70 ft., and..... in. to..... ft. WELL WATER TO BE USED AS: [] Public water supply [] Geothermal [] Injection well [] Domestic [] Feedlot [] Oil field water supply [] Dewatering [] Other (Specify below) [] Irrigation [] Industrial [] Domestic-lawn & garden [] Monitoring well Was a chemical/bacteriological sample submitted to Department? [] Yes [] No If yes, mo/day/yr sample was submitted..... Water well disinfected? [] Yes [] No

5 TYPE OF CASING USED: [] Steel [] PVC [] Other CASING JOINTS: [] Glued [] Clamped [] Welded [] Threaded Casing diameter 16 in. to 50 ft., Diameter..... in. to..... ft., Diameter..... in. to..... ft. Casing height above land surface 24 in., Weight SCH40 lbs./ft., Wall thickness or gauge No. 500 TYPE OF SCREEN OR PERFORATION MATERIAL: [] Steel [] Stainless Steel [] PVC [] Other (Specify) [] Brass [] Galvanized Steel [] None used (open hole) SCREEN OR PERFORATION OPENINGS ARE: [] Continuous slot [] Mill slot [] Gauze wrapped [] Torch cut [] Drilled holes [] None (open hole) [] Louvered shutter [] Key punched [] Wire wrapped [] Saw cut [] Other (specify) SCREEN-PERFORATED INTERVALS: From 50 ft. to 70 ft., From..... ft. to..... ft. From..... ft. to..... ft. GRAVEL PACK INTERVALS: From 70 ft. to 20 ft., From..... ft. to..... ft. From..... ft. to..... ft.

6 GROUT MATERIAL: [] Neat cement [] Cement grout [] Bentonite [] Other Grout Intervals: From..... ft. to..... ft., From..... ft. to..... ft., From..... ft. to..... ft. What is the nearest source of possible contamination: [] Septic tank [] Lateral lines [] Pit privy [] Livestock pens [] Insecticide storage [] Other (specify below) [] Sewer lines [] Cesspool [] Sewage lagoon [] Fuel storage [] Abandoned water well [] Watertight sewer lines [] Seepage pit [] Feedyard [] Fertilizer storage [] Oil well/gas well N/A Direction from well..... Distance from well.....

Table with columns: FROM, TO, LITHOLOGIC LOG, FROM, TO, LITHO. LOG (cont.) or PLUGGING INTERVALS. Rows include soil types like Top soil, Tan clay-sandy, Small sand, Tan clay, Tan clay-sandy, Fine-small sand, Small-fine sand / tan clay mix, Small sand, and Shale.

7 CONTRACTOR'S OR LANDOWNER'S CERTIFICATION: This water well was [] constructed, [] reconstructed, or [] plugged under my jurisdiction and was completed on (mo/day/year) 3/17/2016..... and this record is true to the best of my knowledge and belief. Kansas Water Well Contractor's License No. 134..... This Water Well Record was completed on (mo/day/year) 3/18/2016..... under the business name of Rosencrantz-Bemis Ent..... by (signature).....

INSTRUCTIONS: Use ty pewriter or ball point pen. PLEASE PRESS FIRMLY and PRINT clearly. Please fill in blanks and check the correct answers. Send three copies (white, blue, pink) to Kansas Department of Health and Environment, Bureau of Water, Geology Section, 1000 SW Jackson St., Suite 420, Topeka, Kansas 66612-1367. Telephone 785-296-5524. Send one copy to WATER WELL OWNER and retain one for your records. I include fee of \$5.00 for each constructed well. Visit us at http://www.kdheks.gov/waterwell/index.html.