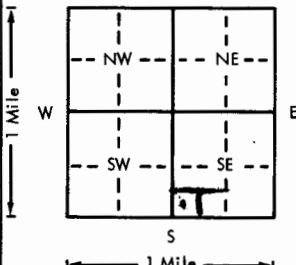
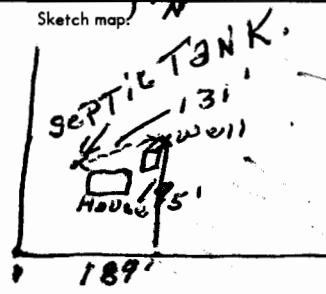


USE TYPEWRITER OR BALL  
POINT PEN-PRESS FIRMLY,  
PRINT CLEARLY.

WATER WELL RECORD  
KSA 82a-1201-1215

Kansas Department of Health and  
Environment-Division of Environment  
(Water well Contractors)  
Topeka, Kansas 66620

1. Location of well: <b>Kingman</b>		County <b>Kingman</b>		Fraction <b>SW 1/4 SW 1/4 SE 1/4</b>		Section number <b>294</b>		Township number <b>T 29 S R 7E</b>		Range number <b>6W</b>	
2. Distance and direction from nearest town or city: <b>2 mi North 1/2 East of Belmont, Kans.</b>						3. Owner of well: <b>Helen Kastner</b> R.R. or street: <b>Kingman, Kans.</b> City, state, zip code:					
4. Locate with "X" in section below:  Sketch map: 						6. Bore hole dia. <b>4 1/4</b> in. Completion date <b>Oct 22-77</b> Well depth <b>34</b> ft.					
5. Type and color of material						7. <input checked="" type="checkbox"/> Cable tool <input checked="" type="checkbox"/> Rotary <input type="checkbox"/> Driven <input type="checkbox"/> Dug <input type="checkbox"/> Hollow rod <input type="checkbox"/> Jetted <input type="checkbox"/> Bored <input type="checkbox"/> Reverse rotary					
8. Use: <input type="checkbox"/> Domestic <input type="checkbox"/> Public supply <input type="checkbox"/> Industry <input type="checkbox"/> Irrigation <input type="checkbox"/> Air conditioning <input checked="" type="checkbox"/> Stock <input type="checkbox"/> Lawn <input type="checkbox"/> Oil field water <input type="checkbox"/> Other						9. Casing: Material <b>PLTS</b> Height <b>Above</b> or below Threaded <input type="checkbox"/> Welded <input type="checkbox"/> Surface <b>12</b> in. RMP <input checked="" type="checkbox"/> PVC <input type="checkbox"/> Weight <input type="checkbox"/> lbs./ft. Dia. <b>5</b> in. to <b>4</b> ft. depth Wall Thickness: inches or Dia. <input type="checkbox"/> in. to <input type="checkbox"/> ft. depth gage No. <b>200</b>					
10. Screen: Manufacturer's name <b>RMP</b> Type <b>RMP</b> Dia. <b>5"</b> Slot/gauze <b>1/8</b> Length <b>10</b> Set between <b>24'</b> ft. and <b>34'</b> ft. Gravel pack? <input checked="" type="checkbox"/> Size range of material <b>18-30</b>						11. Static water level: <b>14</b> ft. below land surface Date <b>Oct 22-77</b> 12. Pumping level below land surfaces: <b>NA</b> ft. after <input type="checkbox"/> hrs. pumping <input type="checkbox"/> g.p.m. <input type="checkbox"/> ft. after <input type="checkbox"/> hrs. pumping <input type="checkbox"/> g.p.m. Estimated maximum yield <input type="checkbox"/> g.p.m.					
13. Water sample submitted: <input checked="" type="checkbox"/> Yes <input type="checkbox"/> No Date <b>Oct 22-77</b>						14. Well head completion: <input checked="" type="checkbox"/> Pitless adapter <b>12</b> inches above grade					
15. Well grouted? <input checked="" type="checkbox"/> With: <input checked="" type="checkbox"/> Neat cement <input type="checkbox"/> Bentonite <input type="checkbox"/> Concrete Depth: From <b>0</b> ft. to <b>12</b> ft.						16. Nearest source of possible contamination: ft. <b>131</b> Direction <b>West</b> Type <b>Septic tank</b> Well disinfected upon completion? <input checked="" type="checkbox"/> Yes <input type="checkbox"/> No					
17. Pump: Manufacturer's name <b>Wells Drilling</b> <input checked="" type="checkbox"/> Not installed Model number <b>10-30</b> HP <b>5</b> Volts <b>54E</b> Length of drop pipe <b>34</b> ft. capacity <b>5</b> g.p.m. Type: <input type="checkbox"/> Submersible <input type="checkbox"/> Turbine <input type="checkbox"/> Jet <input type="checkbox"/> Reciprocating <input type="checkbox"/> Centrifugal <input type="checkbox"/> Other						18. Elevation: Topography: <input type="checkbox"/> Hill <input checked="" type="checkbox"/> Slope <input type="checkbox"/> Upland <input type="checkbox"/> Valley					
19. Remarks: <b>Red Bed.</b>						20. Water well contractor's certification: This well was drilled under my jurisdiction and this report is true to the best of my knowledge and belief. <b>Wells Drilling CO INC</b> Business name <b>10-30 Hwy 54E</b> License No. <b>1413</b> Address <b>Oil Wells</b> Date <b>Nov 13-77</b> Signed <b>Oil Wells</b> Authorized representative					