


1 LOCATION OF WATER WELL: County: Kingman	Fraction NE $\frac{1}{4}$ SW $\frac{1}{4}$ NE $\frac{1}{4}$	Section Number 7	Township Number T 29 S	Range Number R 6W E/W
---	---	----------------------------	----------------------------------	---------------------------------

Distance and direction from nearest town or city street address of well if located within city?

1 N. 1 ~~W~~ of Belmont, Kansas

2	WATER WELL OWNER:	Robert E. Campbell Oil & Gas Operations	
	RR#, St. Address, Box # :	260 N. Rockroad, Suite 110	Board of Agriculture, Division of Water Resources
	City, State, ZIP Code :	Wichita, Kansas 67206	Application Number: Unknown

3 LOCATE WELL'S LOCATION WITH AN "X" IN SECTION BOX: 4 DEPTH OF COMPLETED WELL: 50 ft. ELEVATION: Unknown

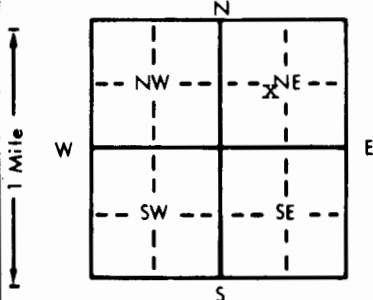

4. DEPTH OF COMPLETED WELL. 50 ft. ELEVATION: Unknown
Depth(s) Groundwater Encountered 1. 18 ft. 2. ft. 3. ft.
WELL'S STATIC WATER LEVEL 18 ft. below land surface measured on mo/day/yr 9/2/81

Pump test data:	Well water was	ft. after	hours pumping	gpm
Est. Yield 60 gpm:	Well water was	ft. after	hours pumping	gpm
Bore Hole Diameter 8 in to 50	ft. and	in to	ft	

WELL WATER TO BE USED AS:				
1 Domestic	3 Feedlot	6 <u>Oil field water supply</u>	9 Dewatering	12 Other (Specify below)
2 Irrigation	4 Industrial	7 Lawn and garden only	10 Observation well	

Was a chemical/bacteriological sample submitted to Department? Yes.....No.....; If yes, mo/day/yr sample was submitted
Water Well Disinfected? Yes.....No.....

5	TYPE OF BLANK CASING USED:	5 Wrought iron	8 Concrete tile	CASING JOINTS: <u>Glued</u> Clamped
	1 Steel	3 RMP (SR)	6 Asbestos-Cement	9 Other (specify below) <u>Welded</u>
	2 PVC	4 ABS	7 Fiberglass	<u>Threaded</u>

Blank casing diameter 5 in. to 30 ft., Dia 2.8 in. to Sch. 40 ft.
Casing height above land surface 12 in., weight lbs./ft. Wall thickness or gauge No.

TYPE OF SCREEN OR PERFORATION MATERIAL:			<u>7 PVC</u>	10 Asbestos-cement
1 Steel	3 Stainless steel	5 Fiberglass	8 RMP (SR)	11 Other (specify)
2 Brass	4 Galvanized steel	6 Concrete tile	9 ABS	12 None used (open hole)

SCREEN OR PERFORATION OPENINGS ARE:		5 Gauzed wrapped	8 <u>Saw cut</u>	11 None (open hole)
1 Continuous slot	3 Mill slot	6 Wire wrapped	9 Drilled holes	
2 Louvered shutter	4 Key punched	7 Torch cut	10 Other (specify)	

SCREEN-PERFORATED INTERVALS:	From	30	ft. to	50	ft., From	ft. to	ft.
	From		ft. to		ft., From	ft. to	ft.
GRAVEL PACK INTERVALS:	From	10	ft. to	50	ft., From	ft. to	ft.
	From		ft. to		ft. From	ft. to	ft.

6] GROUT MATERIAL: 1 Neat cement 2 Cement grout 3 Bentonite 4 Other
Grout Intervals: From 0 ft. to 10 ft., From ft. to ft., From ft. to ft.

What is the nearest source of possible contamination:

1 Septic tank	4 Lateral lines	7 Pit privy	10 Livestock pens	14 Abandoned water well
2 Sewer lines	5 Cess pool	8 Sewage lagoon	11 Fuel storage	15 <u>Oil well/Gas well</u>
3 Watertight sewer lines	6 Seepage pit	9 Feedyard	12 Fertilizer storage	16 Other (specify below)
			13 Insecticide storage

Direction from well? South How many feet? 50

[illegible]

7 CONTRACTOR'S OR LANDOWNER'S CERTIFICATION: This water well was (1) constructed, (2) reconstructed, or (3) plugged under my jurisdiction and was completed on (mo/day/year) 9/2/81 and this record is true to the best of my knowledge and belief. Kansas Water Well Contractor's License No. 186 This Water Well Record was completed on (mo/day/yr) 10/29/81 under the business name of Kellys Water Wells by (signature) [Signature]

INSTRUCTIONS: Use typewriter or ball point pen, PLEASE PRESS FIRMLY and PRINT clearly. Please fill in blanks, underline or circle the correct answers. Send top three copies to Kansas Department of Health and Environment, Division of Environment, Environmental Geology Section, Topeka, KS 66620. Send one to WATER WELL OWNER and retain one for your records.