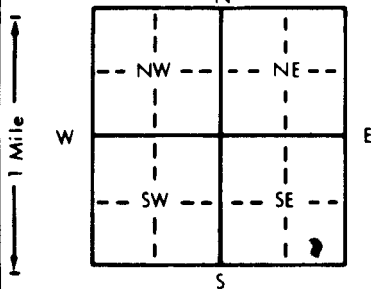


1 LOCATION OF WATER WELL: County: Kingman	Fraction SW 1/4 SE 1/4 SE 1/4	Section Number 29	Township Number T 20 S	Range Number R 6 W E/W
---	---	-----------------------------	----------------------------------	----------------------------------

Distance and direction from nearest town or city street address of well if located within city?

1 1/2 south 1/2 west of Belmont**29**

2 WELL OWNER: Greg Mertens RR#, St. Address, Box # : 149 N St Clair City, State, ZIP Code : Wichita, Ks. 67203	Board of Agriculture, Division of Water Resources Application Number:
---	--

3 LOCATE WELL'S LOCATION WITH AN "X" IN SECTION BOX: 	4 DEPTH OF COMPLETED WELL 50 ft. ELEVATION: Depth(s) Groundwater Encountered 1 20 ft. 2. ft. 3. ft. WELL'S STATIC WATER LEVEL 9 1/2 ft. below land surface measured on mo/day/yr 5-1-98 Pump test data: Well water was ft. after hours pumping gpm Est. Yield 12 gpm: Well water was ft. after hours pumping gpm Bore Hole Diameter 9 in. to 50 ft., and in. to ft. WELL WATER TO BE USED AS: 5 Public water supply 8 Air conditioning 11 Injection well 1 Domestic 3 Feedlot 6 Oil field water supply 9 Dewatering 12 Other (Specify below) 2 Irrigation 4 Industrial 7 Lawn and garden only 10 Monitoring well Was a chemical/bacteriological sample submitted to Department? Yes No: If yes, mo/day/yr sample was submitted Water Well Disinfected? Yes No
--	---

5 TYPE OF BLANK CASING USED: 1 Steel 3 RMP (SR) 5 Wrought iron 8 Concrete tile CASING JOINTS: Glued Clamped 2 PVC 4 ABS 6 Asbestos-Cement 9 Other (specify below) Welded Blank casing diameter in. to ft., Dia. in. to ft., Dia. in. to ft. Casing height above land surface 17 in., weight lbs./ft. Wall thickness or gauge No. 210 TYPE OF SCREEN OR PERFORATION MATERIAL: 1 Steel 3 Stainless steel 5 Fiberglass 7 PVC 10 Asbestos-cement 2 Brass 4 Galvanized steel 6 Concrete tile 8 RMP (SR) 11 Other (specify) SCREEN OR PERFORATION OPENINGS ARE: 1 Continuous slot 3 Mill slot 5 Gauzed wrapped 8 Saw cut 11 None (open hole) 2 Louvered shutter 4 Key punched 6 Wire wrapped 9 Drilled holes SCREEN-PERFORATED INTERVALS: From 44 ft. to 50 ft., From ft. to ft. GRAVEL PACK INTERVALS: From 23 ft. to 50 ft., From ft. to ft. From 3 ft. to 23 ft., From ft. to ft.

6 GROUT MATERIAL: 1 Neat cement 2 Cement grout 3 Bentonite 4 Other Grout Intervals: From 3 ft. to 23 ft., From ft. to ft., From ft. to ft. What is the nearest source of possible contamination: 1 Septic tank 4 Lateral lines 7 Pit privy 10 Livestock pens 14 Abandoned water well 2 Sewer lines 5 Cess pool 8 Sewage lagoon 11 Fuel storage 15 Oil well/Gas well 3 Watertight sewer lines 6 Seepage pit 9 Feedyard 12 Fertilizer storage 16 Other (specify below) 13 Insecticide storage Direction from well? none How many feet? 500

FROM	TO	LITHOLOGIC LOG	FROM	TO	PLUGGING INTERVALS
0	3	soil			
3	25	fine sand			
25	30	sand			
30	36	clean sand, some medium			
36	45	sand fair			
45	50	shale			

7 CONTRACTOR'S OR LANDOWNER'S CERTIFICATION: This water well was (1) constructed, (2) reconstructed, or (3) plugged under my jurisdiction and was completed on (mo/day/year) 5-1-98 and this record is true to the best of my knowledge and belief. Kansas Water Well Contractor's License No. 140 This Water Well Record was completed on (mo/day/yr) under the business name of Lyman Z Inc. by (signature) <i>Lyman Z Inc.</i>
--