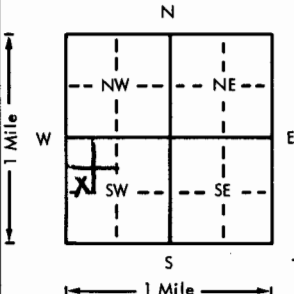
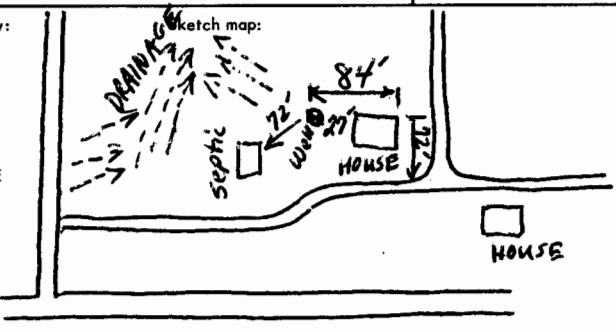


USE TYPEWRITER OR BALL
POINT PEN-PRESS FIRMLY,
PRINT CLEARLY.

WATER WELL RECORD
KSA 82a-1201-1215

Kansas Department of Health and
Environment-Division of Environment
(Water well Contractors)
Topeka, Kansas 66620

1. Location of well: County <u>Kingman</u>		Fraction <u>SW 1/4 NW 1/4 SW 1/4</u>		Section number <u>6</u>	Township number <u>T 29 S</u>	Range number <u>R 7 E</u>
2. Distance and direction from nearest town or city: <u>South end of Cleveland, Ks.</u> Street address of well location if in city:				3. Owner of well: <u>Watson Wieniger</u> R.R. or street: <u>RFD #3</u> City, state, zip code: <u>Kingman, Ks. 67068</u>		
4. Locate with "X" in section below: 		Sketch map: 		6. Bore hole dia. <u>1 7/8</u> in. Completion date <u>Dec 11</u> Well depth <u>70</u> ft.		
5. Type and color of material		From	To	7. <input checked="" type="checkbox"/> Cable tool <input checked="" type="checkbox"/> Rotary <input type="checkbox"/> Driven <input type="checkbox"/> Dug <input type="checkbox"/> Hollow rod <input type="checkbox"/> Jetted <input type="checkbox"/> Bored <input type="checkbox"/> Reverse rotary		
<u>Topsoil</u>		<u>0</u>	<u>2</u>	8. Use: <input checked="" type="checkbox"/> Domestic <input type="checkbox"/> Public supply <input type="checkbox"/> Industry <input type="checkbox"/> Irrigation <input type="checkbox"/> Air conditioning <input type="checkbox"/> Stock <input type="checkbox"/> Lawn <input type="checkbox"/> Oil field water <input type="checkbox"/> Other		
<u>Brn Clay</u>		<u>2</u>	<u>15</u>	9. Casing: Material <u>Plastic</u> Height <u>Above</u> or below Threaded <input type="checkbox"/> Welded <input type="checkbox"/> Surface <u>12</u> in. RMP <input checked="" type="checkbox"/> PVC <input type="checkbox"/> Weight <u> </u> lbs./ft. Dia. <u>5</u> in. to <u>70</u> ft. depth Wall Thickness: inches or Dia. <u> </u> in. to <u> </u> ft. depth Gauge No. <u>200</u>		
<u>Clay V-F Sand</u>		<u>15</u>	<u>20</u>	10. Screen: Manufacturer's name <u>Jess & Lowell</u> Type <u>RMP</u> Dia. <u>5"</u> Slot/gauze <u>1/8"</u> Length <u>15'</u> Set between <u>55</u> ft. and <u>70</u> ft. Gravel pack? <input checked="" type="checkbox"/> Size range of material <u>1/8-3/4</u>		
<u>Sand V-F - Course</u>		<u>20</u>	<u>50</u>	11. Static water level: <u>40</u> ft. below land surface Date <u>12/11/76</u> mo./day/yr.		
<u>Sand Med</u>		<u>50</u>	<u>65</u>	12. Pumping level below land surfaces: <u>40</u> ft. after <u>2</u> hrs. pumping <u> </u> g.p.m. <u> </u> ft. after <u> </u> hrs. pumping <u> </u> g.p.m. Estimated maximum yield <u>20</u> g.p.m.		
<u>Sand Course</u>		<u>65</u>	<u>70</u>	13. Water sample submitted: <u> </u> mo./day/yr. <u> </u> Yes <input checked="" type="checkbox"/> No <u> </u> Date <u> </u>		
<u>Red Bed</u>		<u>-</u>	<u>70</u>	14. Well head completion: <input checked="" type="checkbox"/> Pitless adapter <u>12</u> Inches above grade <input checked="" type="checkbox"/> Well grouted? <u>yes</u> With: <input checked="" type="checkbox"/> Neat cement <input type="checkbox"/> Bentonite <input type="checkbox"/> Concrete Depth: From <u>3</u> ft. to <u>14</u> ft.		
				16. Nearest source of possible contamination: ft. <u>72</u> Direction <u>SW</u> Type <u>septic Tank</u> Well disinfected upon completion? <input checked="" type="checkbox"/> Yes <input type="checkbox"/> No		
				17. Pump: <u>Not installed</u> Manufacturer's name <u>Sta-Rite</u> Model number <u>20SPGD</u> HP <u>3/4</u> Volts <u>220</u> Length of drop pipe <u> </u> ft. capacity <u>20</u> g.p.m. Type: <input checked="" type="checkbox"/> Submersible <input type="checkbox"/> Turbine <input type="checkbox"/> Jet <input type="checkbox"/> Reciprocating <input type="checkbox"/> Centrifugal <input type="checkbox"/> Other		
18. Elevation:		19. Remarks:		20. Water well contractor's certification: This well was drilled under my jurisdiction and this report is true to the best of my knowledge and belief. <u>Wells Drilling Co. #112</u> Business name <u>1030 E. Hwy 54</u> License No. <u> </u> Address <u>Dean K. Wallace</u> Date <u>1/2/77</u> Signed <u> </u> Authorized representative		