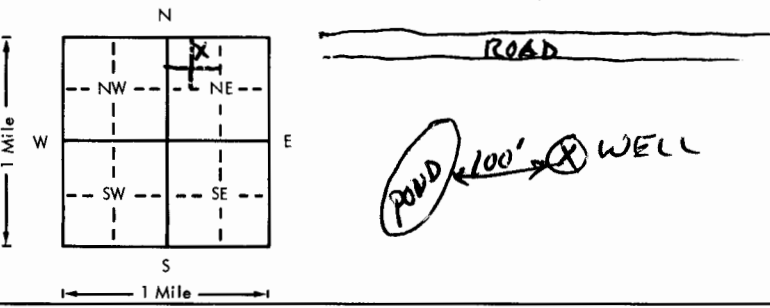


USE TYPEWRITER OR BALL
POINT PEN-PRESS FIRMLY,
PRINT CLEARLY.

WATER WELL RECORD
KSA 82a-1201-1215

Kansas Department of Health and
Environment-Division of Environment
(Water well Contractors)
Topeka, Kansas 66620

1. Location of well:		County KINGMAN	Fraction NE 1/4 NW 1/4 NE 1/4	Section number 14	Township number T 29 S	Range number R 7 E
2. Distance and direction from nearest town or city: 3 1/2 Mi. West				3. Owner of well: URBAN TIEMEYER		
Street address of well location if in city: BELMONT KS.				R.R. or street: RFD 2		
				City, state, zip code: CHENEY, KS. 67025		
4. Locate with "X" in section below:		Sketch map:		6. Bore hole dia. 10 in. Completion date 6/4/79		
				Well depth 70 ft.		
				7. <input checked="" type="checkbox"/> Cable tool <input checked="" type="checkbox"/> Rotary <input type="checkbox"/> Driven <input type="checkbox"/> Dug		
				<input type="checkbox"/> Hollow rod <input type="checkbox"/> Jetted <input type="checkbox"/> Bored <input type="checkbox"/> Reverse rotary		
				8. Use: <input type="checkbox"/> Domestic <input type="checkbox"/> Public supply <input type="checkbox"/> Industry		
				<input type="checkbox"/> Irrigation <input type="checkbox"/> Air conditioning <input checked="" type="checkbox"/> Stock		
				<input type="checkbox"/> Lawn <input type="checkbox"/> Oil field water <input type="checkbox"/> Other		
				9. Casing: Material PET Height: Above or below		
				Threaded <input type="checkbox"/> Welded GLUE Surface 12 in.		
				RMP <input type="checkbox"/> PVC 5/4 40 Weight 2827 lbs./ft.		
				Dia. 5 in. to 60 ft. depth Wall Thickness: inches or		
				Dia. <input type="checkbox"/> in. to <input type="checkbox"/> ft. depth gage No. 258		
5. Type and color of material		From		To		10. Screen: Manufacturer's name PUMPCO
TOP SOIL		0		2		Type PVC Dia. 5"
CLAY		2		8		Slot/Space .030 Length 10 FT
FINE SAND		8		70		Set between 60 ft. and 70 ft.
TERMINATED		70				ft. and <input type="checkbox"/> ft.
						Gravel pack? <input checked="" type="checkbox"/> Size range of material 1/8-3/8
						11. Static water level: 30 ft. below land surface Date 6/4/79
						mg./day/yr.
						12. Pumping level below land surfaces:
						<input type="checkbox"/> ft. after <input type="checkbox"/> hrs. pumping <input type="checkbox"/> g.p.m.
						<input type="checkbox"/> ft. after <input type="checkbox"/> hrs. pumping <input type="checkbox"/> g.p.m.
						Estimated maximum yield 20+ g.p.m.
						13. Water sample submitted: <input type="checkbox"/> Yes <input checked="" type="checkbox"/> No Date <input type="checkbox"/>
						14. Well head completion: 12 Inches above grade
						<input type="checkbox"/> Pitless adapter
						15. Well grouted? <input checked="" type="checkbox"/> With: <input checked="" type="checkbox"/> Neat cement <input type="checkbox"/> Bentonite <input type="checkbox"/> Concrete
						Depth: From 0 ft. to 10 ft.
						16. Nearest source of possible contamination: POND
						ft. 100 Direction W Type POND
						Well disinfected upon completion? <input type="checkbox"/> Yes <input checked="" type="checkbox"/> No
						17. Pump: <input checked="" type="checkbox"/> Not installed
						Manufacturer's name <input type="checkbox"/>
						Model number <input type="checkbox"/> HP <input type="checkbox"/> Volts <input type="checkbox"/>
						Length of drop pipe <input type="checkbox"/> ft. capacity <input type="checkbox"/> g.p.m.
						Type: <input type="checkbox"/> Submersible <input type="checkbox"/> Turbine
						<input type="checkbox"/> Jet <input type="checkbox"/> Reciprocating
						<input type="checkbox"/> Centrifugal <input type="checkbox"/> Other
18. Elevation:		19. Remarks:		20. Water well contractor's certification:		
Topography: <input type="checkbox"/> Hill <input type="checkbox"/> Slope <input checked="" type="checkbox"/> Upland <input type="checkbox"/> Valley		THIS WELL LOCATED IN PASTURE		This well was drilled under my jurisdiction and this report is true to the best of my knowledge and belief.		
				SOUTH CENTRAL IRR. 355		
				Business name 635 S. MAIN, KINGMAN, KS. License No. <input type="checkbox"/>		
				Address Neon K. Wallace Date 7/2/79		
				Signed <input type="checkbox"/> Authorized representative		