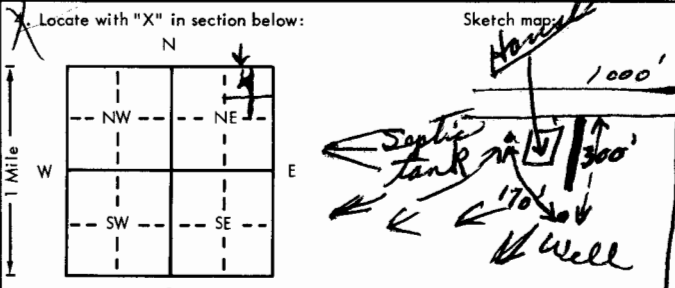


USE TYPEWRITER OR BALL  
POINT PEN-PRESS FIRMLY,  
PRINT CLEARLY.

WATER WELL RECORD  
KSA 82a-1201-1215

Kansas Department of Health and  
Environment-Division of Environment  
(Water well Contractors)  
Topeka, Kansas 66620

1. Location of well:		County <u>Kingman</u>	X Action <u>NE</u> <u>NW 1/4 NE 1/4</u>	Section number <u>21</u>	Township number T <u>29</u> S R <u>7</u> E/W	Range number
X Distance and direction from nearest town or city: <u>9 mi So of Kingman</u> <u>on 14 Hwy</u>			3. Owner of well: <u>Andrew-Loria Campbell</u> R.R. or street: <u>Kingman Kns</u> City, state, zip code: <u>67068</u>			
X Locate with "X" in section below:		Sketch map: 		6. Bore hole dia. <u>9 1/4</u> in. Completion date <u>8/12/78</u> Well depth <u>24</u> ft.		
5. Type and color of material		From	To	7. <input type="checkbox"/> Cable tool <input checked="" type="checkbox"/> Rotary <input type="checkbox"/> Driven <input type="checkbox"/> Dug <input type="checkbox"/> Hollow rod <input type="checkbox"/> Jetted <input type="checkbox"/> Bored <input type="checkbox"/> Reverse rotary		
<u>Red top Soil</u>		<u>0</u>	<u>2</u>	8. Use: <input checked="" type="checkbox"/> Domestic <input type="checkbox"/> Public supply <input type="checkbox"/> Industry <input type="checkbox"/> Irrigation <input type="checkbox"/> Air conditioning <input type="checkbox"/> Stock <input type="checkbox"/> Lawn <input type="checkbox"/> Oil field water <input type="checkbox"/> Other		
<u>Brown Clay</u>		<u>2</u>	<u>10</u>	9. Casing: Material <u>PLTS</u> Height: <u>12</u> in. above or below Threaded <input type="checkbox"/> Welded <input type="checkbox"/> Surface <u>12</u> in. RMP <u>5</u> PVC <input type="checkbox"/> Weight <u>12</u> lbs./ft. Dia. <u>5</u> in. to <u>26</u> ft. depth Wall Thickness: inches or Dia. <u>5</u> in. to <u>26</u> ft. depth gage No. <u>200</u>		
<u>Coarse Sand &amp; Fine Gravel</u>		<u>10</u>	<u>26</u>	10. Screen: Manufacturer's name <u>J &amp; L</u> Type <u>RMP</u> Dia. <u>5"</u> Slot/gauze <u>1/8</u> Length <u>6'</u> Set between <u>17</u> ft. and <u>23</u> ft. ft. and <u>23</u> ft.		
				Gravel pack? <input checked="" type="checkbox"/> Size range of material <u>1/8 to 3/8"</u>		
				11. Static water level: <u>10</u> ft. below land surface Date <u>Aug 12/78</u> mo./day/yr		
				12. Pumping level below land surfaces: ____ ft. after ____ hrs. pumping ____ g.p.m. ____ ft. after ____ hrs. pumping ____ g.p.m. Estimated maximum yield ____ g.p.m.		
				13. Water sample submitted: ____ mo./day/yr. Yes <input checked="" type="checkbox"/> No <input type="checkbox"/> Date ____		
				14. Well head completion: <input checked="" type="checkbox"/> Pitless adapter <u>12</u> Inches above grade		
				15. Well grouted? <input checked="" type="checkbox"/> With: <input type="checkbox"/> Neat cement <input type="checkbox"/> Bentonite <input checked="" type="checkbox"/> Concrete Depth: From <u>1</u> ft. to <u>9</u> ft.		
				16. Nearest source of possible contamination: ft. <u>170</u> Direction <u>NW</u> Type <u>Septic tank</u> Well disinfected upon completion? <input checked="" type="checkbox"/> Yes <input type="checkbox"/> No		
				17. Pump: Manufacturer's name <u>NA</u> Not installed Model number ____ HP ____ Volts ____ Length of drop pipe ____ ft. capacity ____ g.p.m. Type: <input type="checkbox"/> Submersible <input type="checkbox"/> Turbine <input type="checkbox"/> Jet <input type="checkbox"/> Reciprocating <input type="checkbox"/> Centrifugal <input type="checkbox"/> Other		
18. Elevation:		19. Remarks:		20. Water well contractor's certification: This well was drilled under my jurisdiction and this report is true to the best of my knowledge and belief. <u>Wells Drilling Co. 112</u> Business name <u>1030 Hwy 14 E</u> License No. <u>112</u> Address <u>Kingman Kns</u> Signed <u>Dale Wells</u> Date <u>Sept 4-78</u> Authorized representative		