USE TYPEWRITER OR BALL POINT PEN-PRESS FIRMLY, PRINT CLEARLY.

T R EW sec 1/4 1/4 1/4 No.

WATER WELL RECORD
KSA 82a-1201-1215

Kansas State Dept. Of Health
(Water Well Contractors)
Forbes-Bldg. 740
Topeka, Kansas 66620

1 Location of well:	County	Township name	Fraction	Section number	Town number	Range number
	KINGMAN	RICHLAND	NW 1/4	21	29	7

Distance and direction from nearest town or city: 9½ MILES South Kingman
Street address of well location if in city: Kansas

3 Owner of well: George BIRKENBAUGH
Address: Kingman 67068

Locate with "X" in section below:

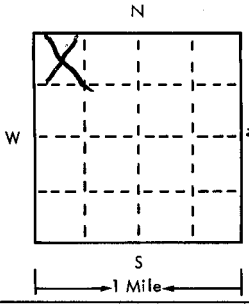

Sketch map:

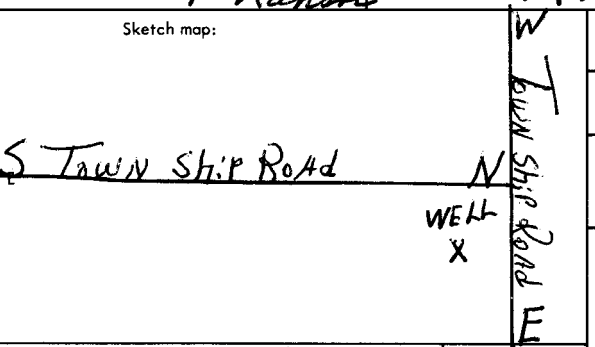

4 Well depth: 40 ft. Date of completion 1-27 75
Well diameter 8" in. IS BORE HOLE

5 ☐ Cable tool ☒ Rotary ☐ Driven ☐ Dug
☐ Hollow rod ☐ Jetted ☐ Bored ☐ Reverse rotary

6 Use: ☒ Domestic ☐ Public supply ☐ Industry
☐ Irrigation ☐ Air conditioning ☐ Commercial
☐ Test well ☐ Human

7 Casing: Material PVC Height: above/below
Threaded ☐ Welded ☐ Surface 24 in.
Diam. 5 in. to 40 ft. depth Weight ___ lbs./ft.
___ in. to ___ ft. depth Drive shoe? ☐ Yes ☒ No

2 Type and color of material	From	To
Soil	0	1
Clay	1	20
Rock 12" INCH Rock	20	21
Sand Clay	21	31
Water Sand	31	40
TOTAL Depth of well 40"		

8 Screen:
Manufacturer Joss x Lowell
Type PVC Dia. 5"
Slot/gauze 1/16 Length 10 feet
Set between 30 ft. and 40 ft.
Fittings:
Gravel pack ☒ Yes ☐ No Size range of material #10

9 Static water level:
30 ft. below land surface Date 1-27 75

10 Pumping level below land surfaces:
___ ft. after N/A hrs. pumping ___ g.p.m.
___ ft. after ___ hrs. pumping ___ g.p.m.
Estimated maximum yield ___ g.p.m.

11 Water sample submitted:
☐ Yes ☒ No Date 1-27 75

12 Well head completion: NOT INSTALLED
☐ Pitless adapter ☐ Inches above grade

13 Well grouted? ☐ Yes ☐ No
☒ Neat cement ☐ Bentonite ☐ ___
Depth: From 1 ft. to 10 ft.

14 Nearest source of possible contamination:
ft. ___ Direction WHEAT Type FIELD
Well disinfected upon completion? ☒ Yes ☐ No

15 Pump: ☒ Not installed
Manufacturer's name ___
Model number ___ HP ___ Volts ___
Length of drop pipe ___ ft. capacity ___ g.m.p.
Type:
☐ Submersible ☐ Turbine
☐ Jet ☐ Reciprocating
☐ Centrifugal ☐ Other

(use a second sheet if needed)

16 Remarks: elevation

Topography:
☒ Hill
☐ Slope
☐ Upland
☐ Valley

17 Water well contractor's certification:
This well was drilled under my jurisdiction and this report is true to the best of my knowledge and belief.
WEBER WELL SERVICE 226
Business name License No.
Address NASHVILLE KANSAS
Signed Leon Weber Date 1-27 75
Authorized representative

Forward the white, blue and pink copies to the Kansas State Dept. Of Health.

Form WWC-5