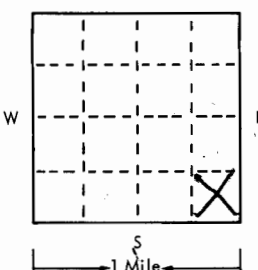
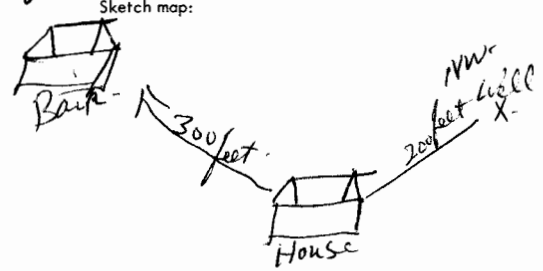


USE TYPEWRITER OR BALL
POINT PEN-PRESS FIRMLY,
PRINT CLEARLY.

WATER WELL RECORD
KSA 82a-1201-1215

T R EW sec 1/4 1/4 1/4 No.

Kansas State Dept. Of Health
(Water Well Contractors)
Forbes-Bldg. 740
Topeka, Kansas 66620

1 Location of well:	County KINSMAN	Township name Belmont	Fraction SE 4	Section number 13	Town number 29	Range number 8	
Distance and direction from nearest town or city 6 miles South of Belmont			3 Owner of well: LAWRENCE BARTON Address: Kinoman Kansas Route 3				
Locate with "X" in section below: 			Sketch map: 			4 Well depth: 26 ft. Date of completion 9-5-75 Well diameter: 8 in.	
2 Type and color of material			From		To		
			Soil		0	1	
			Clay White Clay		1	20	
			Red Rock		20	26	
			Water comes in a Hole in the Red Rock				
TOTAL Depth 26 feet			6 Use: <input checked="" type="checkbox"/> Domestic <input type="checkbox"/> Public supply <input type="checkbox"/> Industry <input type="checkbox"/> Irrigation <input type="checkbox"/> Air conditioning <input type="checkbox"/> Commercial <input type="checkbox"/> Test well				
			7 Casing: Material PTC Height: above below Threaded <input type="checkbox"/> Welded <input type="checkbox"/> Surface 24 in. Diam. 5 in. to 26 ft. depth Drive shoe? <input type="checkbox"/> Yes <input checked="" type="checkbox"/> No 5 in. to 26 ft. depth				
			8 Screen: Manufacturer Jess & Lowell Type PVC Dia. 5 Slot/gauze 1/16 Length 16 Set between 16 ft. and 16 ft. Fittings: Gravel pack <input checked="" type="checkbox"/> Yes <input type="checkbox"/> No Size range of material 4				
			9 Static water level: 16 ft. below land surface Date 9-5-75				
			10 Pumping level below land surfaces: ____ ft. after 1/2 hr. pumping ____ g.p.m. ____ ft. after ____ hrs. pumping ____ g.p.m. Estimated maximum yield ____ g.p.m.				
			11 Water sample submitted: 9-5-75 <input type="checkbox"/> Yes <input checked="" type="checkbox"/> No Date				
			12 Well head completion: Well House <input type="checkbox"/> Pitless adapter <input type="checkbox"/> Inches above grade				
			13 Well grouted? <input checked="" type="checkbox"/> Yes <input type="checkbox"/> No <input checked="" type="checkbox"/> Neat cement <input type="checkbox"/> Bentonite <input type="checkbox"/> Depth: From 1 ft. to 10 ft.				
			14 Nearest source of possible contamination: ft. 300 Direction SW Type Barn yard Well disinfected upon completion? <input checked="" type="checkbox"/> Yes <input type="checkbox"/> No				
			15 Pump: <input type="checkbox"/> Not installed Manufacturer's name NOT INSTALLED Model number ____ HP ____ Volts ____ Length of drop pipe ____ ft. capacity ____ g.m.p. Type: <input type="checkbox"/> Submersible <input type="checkbox"/> Turbine <input type="checkbox"/> Jet <input type="checkbox"/> Reciprocating <input type="checkbox"/> Centrifugal <input type="checkbox"/> Other				
16 Remarks: elevation			17 Water well contractor's certification: This well was drilled under my jurisdiction and this report is true to the best of my knowledge and belief. WEBER Well Service 226 Business name License No. ____ Address Nashville Kansas Signed Don G. Weber Date 9-5-75 Authorized representative				