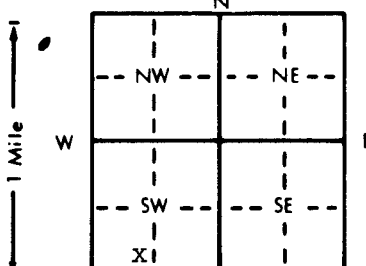


1 LOCATION OF WATER WELL: County: <u>Kingman</u>	Fraction <u>SE</u> $\frac{1}{4}$ <u>SE</u> $\frac{1}{4}$ <u>SW</u> $\frac{1}{4}$	Section Number <u>17</u>	Township Number <u>T 29 S</u>	Range Number <u>R 9</u> 10W
---	---	-----------------------------	----------------------------------	---

Distance and direction from nearest town or city street address of well if located within city?

1 1/2 Miles West Of Willowdale, Kansas

2 WATER WELL OWNER: <u>Richard Molitor</u> RR#, St. Address, Box # : <u>11558 SW 90th ST.</u> City, State, ZIP Code : <u>Zenda, Kansas 67159</u>	Board of Agriculture, Division of Water Resources Application Number:
--	--

3 LOCATE WELL'S LOCATION WITH AN "X" IN SECTION BOX: 	4 DEPTH OF COMPLETED WELL: <u>91</u> ft. ELEVATION: Depth(s) Groundwater Encountered <u>1</u> <u>46'</u> ft. 2. ft. 3. ft. WELL'S STATIC WATER LEVEL <u>44'</u> ft. below land surface measured on mo/day/yr <u>Nov. 3 - 1995</u> Pump test data: Well water was ft. after hours pumping gpm Est. Yield <u>35</u> gpm: Well water was <u>NA</u> ft. after hours pumping gpm Bore Hole Diameter <u>7 7/8"</u> in. to <u>91'</u> ft. and in. to ft. WELL WATER TO BE USED AS: 5 Public water supply 8 Air conditioning 11 Injection well XX1 Domestic 3 Feedlot 6 Oil field water supply 9 Dewatering 12 Other (Specify below) 2 Irrigation 4 Industrial 7 Lawn and garden only 10 Monitoring well Was a chemical/bacteriological sample submitted to Department? Yes No <u>X</u> ; If yes, mo/day/yr sample was submitted Water Well Disinfected? Yes <u>X</u> No
--	---

5 TYPE OF BLANK CASING USED: 1 Steel 3 RMP (SR) 5 Wrought iron 8 Concrete tile XX2 PVC 4 ABS 6 Asbestos-Cement 9 Other (specify below) 7 Fiberglass Blank casing diameter <u>5"</u> in. to <u>75'</u> ft. Dia. in. to ft. Dia. in. to ft. Casing height above land surface <u>16"</u> in. weight <u>160</u> lbs./ft. Wall thickness or gauge No. <u>SDR 26</u> TYPE OF SCREEN OR PERFORATION MATERIAL: 1 Steel 3 Stainless steel 5 Fiberglass 8 RMP (SR) 10 Asbestos-cement 2 Brass 4 Galvanized steel 6 Concrete tile 9 ABS 12 None used (open hole) SCREEN OR PERFORATION OPENINGS ARE: 1 Continuous slot 3 Mill slot 5 Gauzed wrapped XXX8 Saw cut 11 None (open hole) 2 Louvered shutter 4 Key punched 6 Wire wrapped 9 Drilled holes 7 Torch cut 10 Other (specify) SCREEN-PERFORATED INTERVALS: From <u>91'</u> ft. to <u>75'</u> ft. From ft. to ft. From ft. to ft. From ft. to ft. GRAVEL PACK INTERVALS: From <u>91'</u> ft. to <u>64'</u> ft. From ft. to ft. From <u>60'</u> ft. to <u>38'</u> ft. From ft. to ft.
--

6 GROUT MATERIAL: 1 Neat cement 2 Cement grout XX3 Bentonite 4 Other Grout Intervals: From <u>64'</u> ft. to <u>60'</u> ft. From <u>38'</u> ft. to <u>5'</u> ft. From ft. to ft. What is the nearest source of possible contamination: 1 Septic tank 4 Lateral lines 7 Pit privy XX10 Livestock pens 14 Abandoned water well 2 Sewer lines 5 Cess pool 8 Sewage lagoon 11 Fuel storage 15 Oil well/Gas well 3 Watertight sewer lines 6 Seepage pit 9 Feedyard 12 Fertilizer storage 16 Other (specify below) 13 Insecticide storage Direction from well? <u>North</u> How many feet? <u>APP: 190'</u>
--

FROM	TO	LITHOLOGIC LOG	FROM	TO	PLUGGING INTERVALS
0'	3'	Top Soil.			
3'	6'	Fine Sand.			
6'25'	25'	Brown Clay.			
25'	35'	Brown Sandy Clay.			
35'	61'	Medium Course sand W/ Clay strips.			
61'	74'	Medium Course Sand W/Clay strips.			
74'	90'	Course Sand & Fine Gravel.			
90'	91'	Clay Strip.			

7 CONTRACTOR'S OR LANDOWNER'S CERTIFICATION: This water well was (1) <u>constructed</u> , (2) reconstructed, or (3) plugged under my jurisdiction and was completed on (mo/day/year) <u>Nov. 3 - 1995</u> and this record is true to the best of my knowledge and belief. Kansas Water Well Contractor's License No. <u>112</u> . This Water Well Record was completed on (mo/day/yr) <u>Nov 8 - 1995</u> under the business name of <u>Wells Drilling Co.</u> by (signature) <u>Dal Wells</u>
--