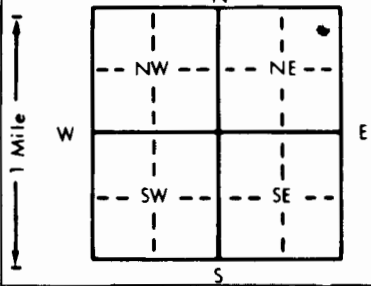


1 LOCATION OF WATER WELL: County: Kingman		Fraction SE 1/4 NE 1/4 NE 1/4	Section Number 9	Township Number T 29 S	Range Number R 9 W E/W
Distance and direction from nearest town or city street address of well if located within city? 2 miles north of Willowdale					
2 WATER WELL OWNER: Steve Conrardy RR#, St. Address, Box #: 8948 S W 100 Ave City, State, ZIP Code: Spivay, Ks. 67142		Board of Agriculture, Division of Water Resources Application Number:			
submitted Water Well Disinfected? Yes No			
TYPE OF SCREEN OR PERFORATION MATERIAL: 1 Steel 3 Stainless steel 5 Fiberglass 7 PVC 10 Asbestos-cement 2 Brass 4 Galvanized steel 6 Concrete tile 8 RMP (SR) 11 Other (specify) SCREEN OR PERFORATION OPENINGS ARE: 1 Continuous slot 3 Mill slot 5 Gauzed wrapped 8 Saw cut 11 None (open hole) 2 Louvered shutter 4 Key punched 6 Wire wrapped 9 Drilled holes SCREEN-PERFORATED INTERVALS: From 45 ft. to 50 ft., From 50 ft. to 52 ft. GRAVEL PACK INTERVALS: From 23 ft. to 52 ft., From 52 ft. to 52 ft.		12 None used (open hole)			
6 GROUT MATERIAL: 1 Neat cement 2 Cement grout 3 Bentonite 4 Other Grout Intervals: From 3 ft. to 23 ft., From 23 ft. to 52 ft., From 52 ft. to 52 ft.		What is the nearest source of possible contamination: 1 Septic tank 4 Lateral lines 7 Pit privy 10 Livestock pens 14 Abandoned water well 2 Sewer lines 5 Cess pool 8 Sewage lagoon 11 Fuel storage 15 Oil well/Gas well 3 Watertight sewer lines 6 Seepage pit 9 Feedyard 12 Fertilizer storage 16 Other (specify below) 13 Insecticide storage Direction from well? SE How many feet? 300			
FROM TO LITHOLOGIC LOG		FROM TO PLUGGING INTERVALS			
0	2	soil			
2	6	dirty sand			
6	40	clay			
40	42	dirty sand			
42	45	fine sand			
45	50	sand			
50	52	clay			
7 CONTRACTOR'S OR LANDOWNER'S CERTIFICATION: This water well was (1) <u>constructed</u> , (2) reconstructed, or (3) plugged under my jurisdiction and was completed on (mo/day/year) 10-30-97 and this record is true to the best of my knowledge and belief. Kansas Water Well Contractor's License No. 140 This Water Well Record was completed on (mo/day/yr) 11-25-97 under the business name of Lyman Inc. by (signature) <i>Steve Conrardy</i>					